

Perry
Q 18
6-19-73

MISSISSIPPI
BOARD OF WATER COMMISSIONERS
416 North State Street
Jackson, Mississippi 39201

WATER WELL DRILLERS LOG

CODED

6-19 1973 J. M. Gibson Perry
date well completed firm name county well located

LANDOWNER: J. M. Gibson
Bliggins Mrs

description of formations encountered	from	to
	Top Soil	0
Red Clay	3	18
Fine Sand	18	32
Blue Clay	32	176
Fine Sand	176	201
Coarse Sand	201	218

(mailing address)

WELL LOCATION:

sec. 17 T 1 N R 11 E
S W
15 miles N of Wiggins
(distance) (direction) (nearest town)

WELL PURPOSE:

(home, irrigation, municipal, industrial)

WELL COMPLETION DATA:

- (1) diameter (inches) 2
- (2) total depth (feet) 218
- (3) static water level (feet) 90 below above top of ground.
- (4) casing Plast, 213,
(material) (depth)
 if telescope see back.
(size)
- (5) screen 5, 213
(length) (depth to top)
2,
(size) (material)
- (6) pump 1 6
(HP) (yield gpm)
Elect
(type power)
- (7) electric log
(yes or no)

(organization running log)
- (8) how well bottom plugged


CODED

DRILLERS REMARKS:

NOV 5 1973

If well telescopes please sketch and show depths.

GROUND LEVEL

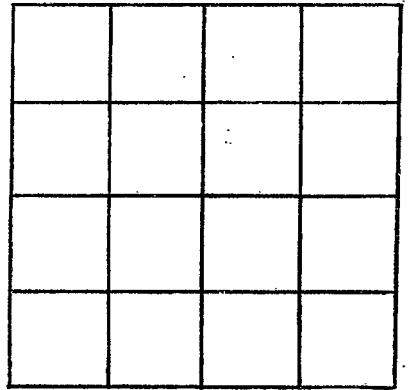

SECTION _____

Please indicate well location X.

ADDITIONAL INFORMATION

If more than one screen,
show locations of each on sketch.