

Perry
Q19
3-8-74

MISSISSIPPI
BOARD OF WATER COMMISSIONERS
416 North State Street
Jackson, Mississippi 39201

CODED

WATER WELL DRILLERS LOG

Perry
~~Landowner~~

3-8 1974 Parnell Anderson
date well completed firm name county well located

LANDOWNER:

R. L. Taylor

(mailing address)

description of formations encountered

from

to

Top Soil 0 4
Pink Clay 4 70
Fine Sand 40 70
Course Sand 70 84

WELL LOCATION:

sec. 30 T. 1 S. R. 11 E.
8 miles W of Bord.
(distance) (direction) (nearest town)

WELL PURPOSE: DOM
(home, irrigation, municipal, industrial)

WELL COMPLETION DATA:

- (1) diameter (inches) 2"
- (2) total depth (feet) 84
- (3) static water level (feet) 60' below top of ground.
- (4) casing Plastic, 79'
(material) (depth)
- (size) If telescope see back.
- (5) screen 5', 79'
(length) (depth to top)
- 2", Plastic
(size) (material)
- (6) pump 1 10
(HP) (yield gpm)
- Elect
(type power)
- (7) electric log NO
(yes or no)
- NO
(organization running log)
- (8) how well bottom plugged
Backwash Valve

CODED

DRILLERS REMARKS:


INDEXED
REGISTERED
MAY 1974

APR - 5 1974

MISS. BD. OF WATER COMM

If well telescopes please sketch and show depths.

GROUND LEVEL

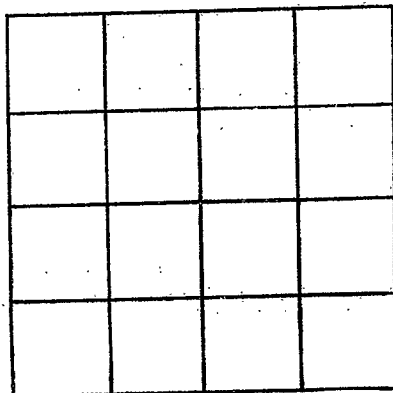

SECTION _____

Please indicate well location X.

ADDITIONAL INFORMATION

If more than one screen, show locations of each on sketch.