

Perry
 Q 20
 7-15-74

MISSISSIPPI
 BOARD OF WATER COMMISSIONERS
 416 North State Street
 Jackson, Mississippi 39201

WATER WELL DRILLERS LOG

CODED

7-15-74
 date well completed

1974 Ornell Anderson Perry
 firm name

county well located

LANDOWNER:

Ray Harris

(mailing address)

WELL LOCATION:

sec. 20 T 1 S R 11 W
8 miles NE of Bond
 (distance) (direction) (nearest town)

WELL PURPOSE: HOME
 (home, irrigation, municipal, industrial)

WELL COMPLETION DATA:

- (1) diameter (inches) 2"
- (2) total depth (feet) 105'
- (3) static water level (feet) 28' below top of ground.
- (4) casing Plastic, 100'
 (material) (depth)
 _____ if telescope see back.
 (size)
- (5) screen 5', 100'
 (length) (depth to top)
2", Plastic
 (size) (material)
- (6) pump 1 12
 (HP) (yield gpm)
Elect
 (type power)
- (7) electric log no
 (yes or no)
- _____ (organization running log)

(8) how well bottom plugged
Back with rubble

description of formations encountered

from to

<u>Top Soil</u>	<u>0</u>	<u>4</u>
<u>Red Clay</u>	<u>4</u>	<u>29</u>
<u>White Clay</u>	<u>29</u>	<u>85</u>
<u>Coarse Sand</u>	<u>85</u>	<u>105</u>

CODED


RECEIVED

AUG - 2 1974

DRILLERS REMARKS:

If well telescopes please sketch and show depths.

GROUND LEVEL

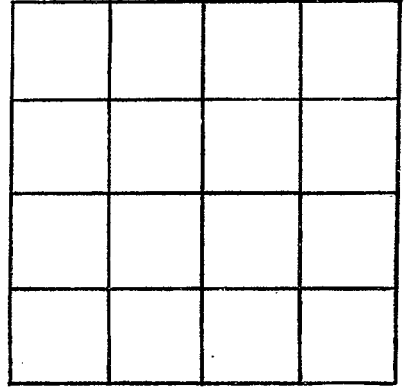

SECTION _____

Please indicate well location X.

ADDITIONAL INFORMATION

If more than one screen, show locations of each on sketch.