

Perry  
QZ1  
9/20/79

MISSISSIPPI  
BOARD OF WATER COMMISSIONERS  
416 North State Street  
Jackson, Mississippi 39201

CODED

WATER WELL DRILLERS LOG

9-20 date well completed  
Parnell Anderson firm name  
Perry county well located

LANDOWNER:  
W E Simmons  
Rt 1 Bond  
(mailing address)

description of formations encountered	from	to
Top Soil	0	4
Red Clay	4	25
Sandy Clay	28	80
Fin Sand	80	100
Coarse Sand	110	130

WELL LOCATION:  
sec. 30 T-1 R-11 E  
6 miles E of Bond  
(distance) (direction) (nearest town)

WELL PURPOSE: HOME  
(home, irrigation, municipal, industrial)

WELL COMPLETION DATA:

(1) diameter (inches) 2"

(2) total depth (feet) 120'

(3) static water level (feet) 20' below top of ground.

(4) casing Plastic, 115'  
(material) (depth)

(size) If telescope see back.

(5) screen 5' 115'  
(length) (depth to top)

2" Plastic  
(size) (material)

(6) pump 1 7  
(HP) (yield gpm)

E Oct  
(type power)

(7) electric log no  
(yes or no)

(organization running log)


(8) how well bottom plugged  
Back wash valve

REGISTERED  
OCT 10 1979

DRILLERS REMARKS:

If well telescopes please sketch and show depths.

GROUND LEVEL

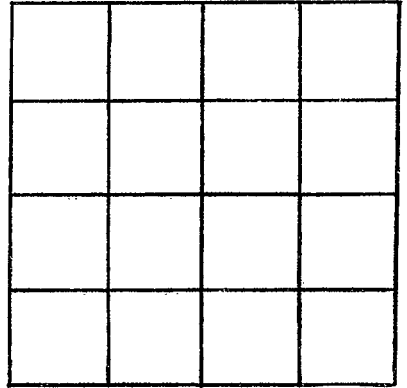

SECTION \_\_\_\_\_

Please indicate well location X.

ADDITIONAL INFORMATION

If more than one screen,  
show locations of each on sketch.