

Q 23  
 Perry  
 5/13/75

MISSISSIPPI  
 BOARD OF WATER COMMISSIONERS  
 416 North State Street  
 Jackson, Mississippi 39201


CODED

WATER WELL DRILLERS LOG

5-13 1975 Parnell Anderson Perry  
 date well completed firm name county well located

LANDOWNER:	description of formations encountered	from	to
<u>Loss Shop</u>	<u>Top Soil</u>	<u>0</u>	<u>7</u>
(mailing address)	<u>Sandy clay</u>	<u>7</u>	<u>22</u>
WELL LOCATION:	<u>Fin sand</u>	<u>22</u>	<u>64</u>
sec. <u>26</u> T. <u>1</u> S. R. <u>11</u> E. W. <u>8</u>	<u>Coarse sand</u>	<u>64</u>	<u>85</u>
<u>10</u> miles <u>E</u> of <u>Wagon</u>			
(distance) (direction) (nearest town)			
WELL PURPOSE: <u>HOME</u>			
(home, irrigation, municipal, industrial)			
WELL COMPLETION DATA:			
(1) diameter (inches) <u>2"</u>			
(2) total depth (feet) <u>85'</u>			
(3) static water level (feet) <u>45</u> ~below above top of ground.			
(4) casing <u>Plastic 20'</u> (material) (depth)			
(size) if telescope see back.			
(5) screen <u>5'</u> <u>80'</u> (length) (depth to top)			
<u>2"</u> <u>Plastic</u> (size) (material)			
(6) pump <u>1</u> <u>9</u> (HP) (yield gpm)			
<u>Elect</u> (type power)			
(7) electric log <u>no</u> (yes or no)			
(organization running log)			
(8) how well bottom plugged <u>Backwash Valve</u>			
DRILLERS REMARKS:			


5 mi NE

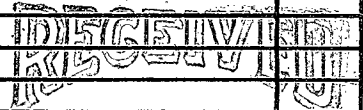

MISS. BD. OF WATER COMM

If well telescopes please  
sketch and show depths.

GROUND LEVEL

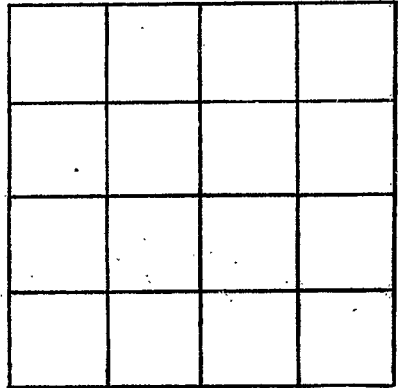

SECTION \_\_\_\_\_

Please indicate well location X.

ADDITIONAL INFORMATION

A series of horizontal lines providing space for additional information. The lines are evenly spaced and extend across the width of the form.

If more than one screen,  
show locations of each on sketch.