

GW-12507

#2 South

C. P. CLARK

WATER WELL DRILLING

MISSISSIPPI

ROUTE 2

BOARD OF WATER COMMISSIONERS MISS. 39440

416 North State Street

Jackson, Mississippi 39201

WATER WELL DRILLERS LOG

LOG

Perry
Q24
10/24/78
Log # 125

C. P. Clark

Perry

date well completed

firm name

county well located

LANDOWNER: James W. Asc.
 RT #1
Brooklyn Miss.
 (mailing address)

description of formations encountered	from	to
Red Sandy Clay	0	10
Sand	10	119
White Clay	119	140
Green Clay	140	198
Sand	198	201
Clay	201	276
Sandy Clay	276	288
Clay	288	482
Sandy Clay	482	498
Clay	498	510
Sandy Clay	510	516
Hard Clay	516	802
Fine Sand	802	836
Sand & Clay	836	894
Sand	894	952

WELL LOCATION:
 sec. 25 T 1 N R 11 E
8 miles NE of Wiggins
 (distance) (direction) (nearest town)

WELL PURPOSE: Community system
 (home, irrigation, municipal, industrial)

WELL COMPLETION DATA:

(1) diameter (inches) 6

(2) total depth (feet) 952

(3) static water level (feet) 198 below top of ground.

(4) casing Black Coated 890
 (material) (depth)

4 if telescope see back.
 (size)

(5) screen 42 910
 (length) (depth to top)

4 in Solid S.S.
 (size) (material)

(6) pump 15 125 @ 55#
 (HP) (yield gpm) psi

2300 34
 (type power)

(7) electric log Yes
 (yes or no)

State Geo. Survey
 (organization running log)


(8) how well bottom plugged BWU

RECEIVED
 JAN 15 1978

MISS. BOARD OF WATER COMMISSIONERS

DRILLERS REMARKS: Set Pump
@ 294 - 15 H.P.
Red Jacket - Run E
Log 5/5/78 test hole

If well telescopes please sketch and show depths.

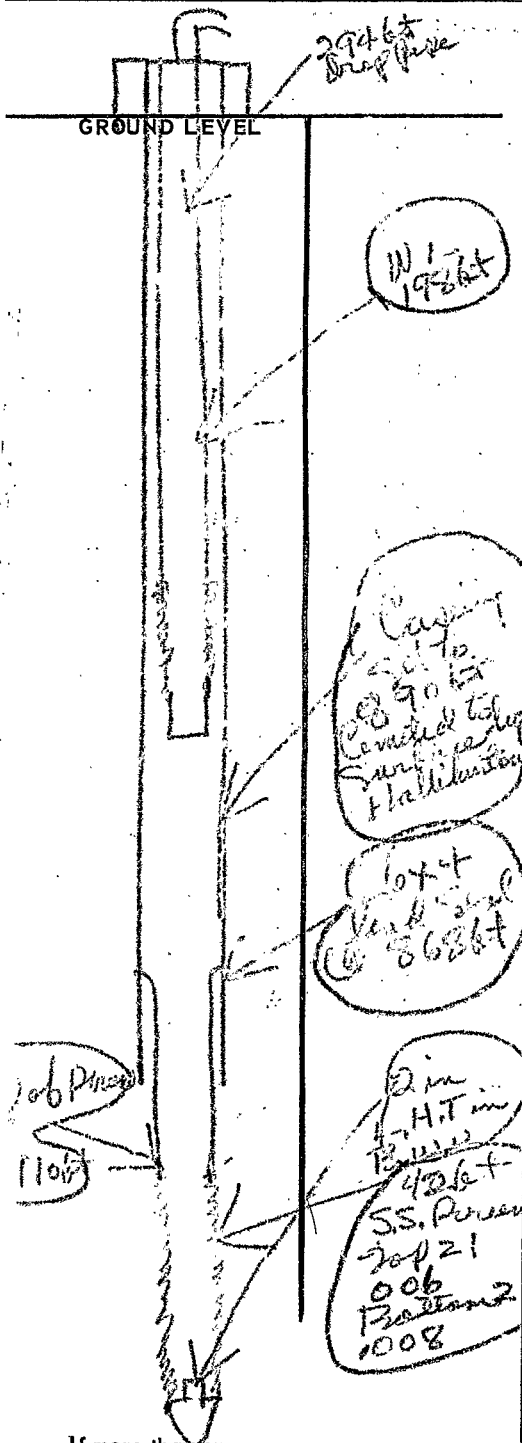

X			

SECTION 25

Please indicate well location X.

ADDITIONAL INFORMATION

Used 415 Co. bit on
to Mineral Member
(estimated) 250 P.M.
allow in Water

If more than one screen, show locations of each on sketch.