

MISSISSIPPI DEPARTMENT OF NATURAL RESOURCES

Bureau of Land and Water Resources

Southport Mall

P.O. Box 10631

Jackson, Mississippi 39209

WATER WELL DRILLERS LOG

CODING

Griner Drilling Service, Inc.

Perry

PERRY
Q 26
3-25-81

date well completed

firm name

county well located

LANDOWNER:

Ladd Petroleum
2121 Sage Road
Suite 300
Houston, Texas 77056

description of formations encountered

from

to

clay & sand

0 530

sand

530 575

clay

575 590

sand

590 630

clay

630 650

WELL LOCATION: *2200'S + 2100'W*

CROWN
sec. 33 T 1 N R 11 E of
Zellerbach #7 Wiggins
NE/CO

(distance) (direction) (nearest town)

WELL PURPOSE: *oil field supply*

WELL COMPLETION DATA:

- (1) diameter (inches) *4"*
- (2) total depth (feet) *650'*
- (3) static water level (feet) *170' below top of ground.*
- (4) casing *steel, 630'*
(material) (depth)
4" If telescope see back.
(size)
- (5) screen *42', 588'*
(length) (depth to top)
4", perforated
(size) (material)
- (6) pump *80*
(HP) (yield gpm)
AC
(type power)
- (7) electric log *—*
(yes or no)

(organization running log)

(8) how well bottom plugged *orange peat*

DRILLERS REMARKS:


DEPT. OF NATURAL RESOURCES
BUREAU OF LAND & WATER RESOURCES

APR - 3 1981

RECEIVED

If well telescopes please sketch and show depths.

GROUND LEVEL

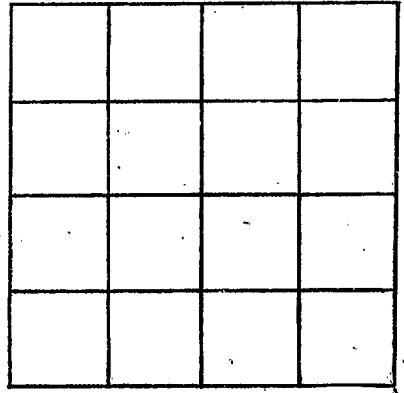

SECTION _____

Please indicate well location X.

ADDITIONAL INFORMATION

If more than one screen,
show locations of each on sketch.