

MISSISSIPPI DEPARTMENT OF NATURAL RESOURCES

Bureau of Land and Water Resources

Southport Mall

P.O. Box 10631

Jackson, Mississippi 39209

WATER WELL DRILLERS LOG

Q27
Perry Co.
2-29-84

CODED.

2/29 1984 Braden Pump & Well Serv^{inc.} Perry County
date well completed firm name county well located

LANDOWNER: Perry Lee
4802 Ala. Ave.
Southport, Ms. 39501
(mailing address)

WELL LOCATION:
sec. 11 T 1 S R 11 E
1 1/2 miles S of Stephens
(distance) (direction) (nearest town)

WELL PURPOSE: home
(home, irrigation, municipal, industrial)

WELL COMPLETION DATA:

- (1) diameter (inches) 2"
- (2) total depth (feet) 420
- (3) static water level (feet) 180 below top of ground.
- (4) casing PVC 400'
(material) (depth)
2" if telescope see back.
(size)
- (5) screen 10' 400'
(length) (depth to top)
2" PVC underbar
(size) (material)
- (6) pump 1 1/2 6
(HP) (yield gpm)
230
(type power)
- (7) electric log no
(yes or no)
(organization running log)
- (8) how well bottom plugged PVC
sandshark

description of formations encountered	from	to
red sandy clay	0	20
clay + sand	20	40
clay	40	80
white clay	80	100
clay + sand	100	120
gray clay	120	180
clay + sand	180	200
gray clay	200	260
clay + sand	260	280
gray clay	280	360
fine sand	360	380
sand	380	420

DEPT. OF NATURAL RESOURCES
BUREAU OF LAND & WATER RESOURCES


MAR 23 1984

RECEIVED

DRILLERS REMARKS: 10 ft.
tailpipe

If well telescopes please sketch and show depths.

GROUND LEVEL

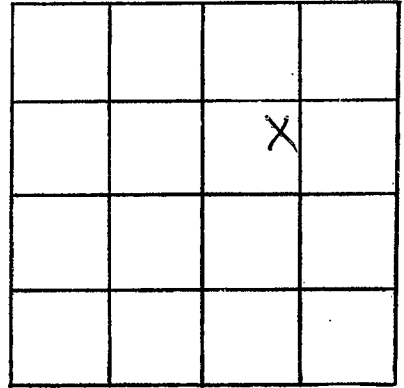

SECTION 11

Please indicate well location X.

ADDITIONAL INFORMATION

If more than one screen,
show locations of each on sketch.