

Perry
 County: Forrest
 Parish #: _____
 Driller: Travis Boone
 Date drilling completed: 8-14-07

State Well Report
 Part 1

Mississippi Department of Environmental Quality
 Office of Land and Water Resources
 P.O. Box 10631
 Jackson, MS 39289-0631
 (601)961-5210
 (601)354-6938 (fax)

For Office Use Only
 Aquifer: _____
 Well #: Q-40
 L. S. Elevation: _____
 E-log #: _____

State Law requires that this report be prepared by the driller in detail and filed with the Department within 30 days of completion of drilling of the well.

Well Owner Information	Well Location
Owner Name: <u>Allen Smith</u>	Latitude: _____ Longitude: _____
Mailing Address: <u>100 Armstrong Rd</u>	Method of Lat/Long (circle one): <input type="radio"/> Conventional Survey
<u>Brooklynn, MS</u>	<input type="radio"/> USGS quad, <input type="radio"/> Hand-held GPS, <input type="radio"/> Survey-grade GPS
<u>39425</u>	<u>14</u> <u>14</u> Sec <u>4</u> Twn <u>15</u> Rng <u>11W</u>
City State Zip Code	Distance Direction Nearest Town
Telephone No. () _____	<u>7.2</u> Miles <u>E</u> of <u>Brooklynn</u>

Well Data

Purpose of Well (circle one) Home Industrial Public Supply Irrigation Fish Culture Other: _____

Date well drilling started: 8-10-07 Date well drilling completed: 8-14-07

If flowing, method of flow regulation: Valve _____ Other (describe) _____

Static Water Level: 150 feet above or below (circle one) land surface Date measured: 8-14-07

Method of Measurement (circle one) steel tape electric tape air line other: String Line

Hole depth: _____ Well depth: 550 Well grouted to a depth of 10 feet

Type of grout (circle one): Cement Bentonite Mix

Casing length: 530 feet Casing diameter: 4 inches Type of casing: sch 40

Screen length: 20 feet Screen diameter: 4 inches Type of screen: sch 40

Screen slot size: 8 inches Setting depth: From 530 feet to 550 feet

Type of completion (circle all applicable): Gravel packed Underreamed Telescoped Open hole Natural Development

Other (describe): _____

Top of log pipe or reduction in casing: _____ feet. If telescoped or more than one screen, describe on back of page

Logs run (circle all applicable): No log run Electric Gamma Ray Density Sonic Neutron Other: _____

Name of organization running log(s): _____

I certify that the well was drilled, constructed, and completed in accordance with all applicable requirements of the Mississippi Department of Environmental Quality and/or the Mississippi Department of Health regulations and state laws.

Travis Boone 0-514 _____
 Print Name of Water Well Contractor and License No. Signature of Water Well Contractor

RECEIVED
 SEP 14 2007
 BY: OLWR

SEP-14-2002 04:26P FROM:


TO: 16013600535

P: 3

Q-40

If well telescopes please sketch below and show depths.

Ground Level

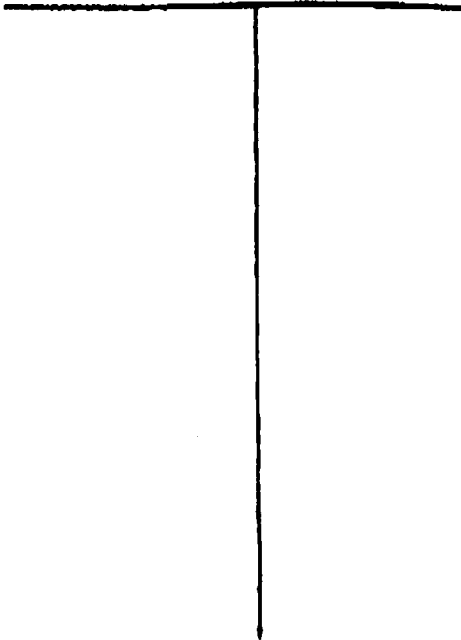

Description of Formations Encountered

From To

1' clay	0	4ft
2' clay	4ft	5ft

If more than one screen, show location of each on sketch

Sketch the property layout and include the following: 1) the well location; 2) any permanent structures on the property that may aid in locating the well; 3) any roads, power lines, or other items that may aid in locating the property and the well; 4) indicate direction.

Landowner Name: Allen Smith

[Signature]
Signature of Water Well Contractor

RECEIVED
SEP 14 2007
BY: OLWR

SEP-14-2002 04:26P FROM:

TD:16013600535

P:2

Perry

STATE WELL REPORT

Part 2

Pump Installer's Completion Report
 Mississippi Department of Environmental Quality
 Office of Land and Water Resources
 P.O. Box 10631
 Jackson, MS 39289-0631
 (601)961-9210
 (601)354-6938 (fax)

For Office Use Only:

Appltr: _____

Well #: Q-40

Elevation: _____

County: Jordan
 Permit #: _____
 Installer: Travis Boone
 Date completed: 8-14-07

This report should be prepared by the pump installer in detail and filed with the Department within 30 days of the installation of pump.

Well Owner Information	Well Location
Owner Name: <u>Allen Smith</u>	Latitude: _____ Longitude: _____
Mailing Address: <u>100 Armstrong Rd</u> <u>Brooklyns</u> <u>39425</u>	Method of Lat/Long (circle one): <u>Conventional Survey</u> USGS quad, Hand-held GPS, Survey-grade GPS
City: _____ State: _____ Zip Code: _____	<u>4</u> <u>4</u> Sec <u>4</u> Twn <u>15</u> Rng <u>11W</u>
Telephone No. (_____) _____	Distance: <u>7 1/2</u> miles Direction: <u>E</u> of Nearest Town: <u>Brooklyn</u>

Pump Type Circle one	Power Type Circle one
Air Lift: <input type="checkbox"/> Jet: <input type="checkbox"/> <u>Submersible</u>	Diesel Engine: <input type="checkbox"/> Gasoline Engine: <input type="checkbox"/> Natural Gas: <input type="checkbox"/>
Bucket: <input type="checkbox"/> Piston: <input type="checkbox"/> Turbine: <input type="checkbox"/>	<u>Electric Motor</u> : <input type="checkbox"/> Hand: <input type="checkbox"/> Tumbler PTO: <input type="checkbox"/>
Coverings: <input type="checkbox"/> Rotary: <input type="checkbox"/> Flowing Well: <input type="checkbox"/>	Windmill: <input type="checkbox"/> Other (specify): _____
Other (specify): _____	Motor Power Rating of Motor: <u>1</u>
Date Pump Installed: <u>8-14-07</u>	Setting Depth: <u>190</u> feet
Rated Pump Capacity: <u>12</u> Gallons Per Minute	Number of Stages: _____

Pump Test Data	Method of Measuring Water Level Circle one
Date Well Tested: <u>8-14-07</u>	Air Line: <input type="checkbox"/> Electric Measuring Line: <input type="checkbox"/> Steel Tape: <input type="checkbox"/>
Static Water Level (A): <u>150</u> Feet Below Land Surface	Other (specify): <u>string line</u>
Pumping Water Level (B): _____ Feet Below Land Surface	For flowing well, measured static in test: _____ feet
Drawdown (B) - (A): _____ Feet Below Land Surface	Well yielded _____ GPM with a drawdown of _____ feet after _____ hours of pumping
Test Pumping Rate: <u>12 GPM</u> Gallons Per Minute	
Duration of Pump Test (minimum 4 hours): _____ hours	

I HEREBY CERTIFY that the above statements are true to the best of my knowledge.

Travis Boone
 Print Name of Pump Installer and License No. (if applicable)

Travis Boone
 Signature of Pump Installer

RECEIVED
 SEP 14 2007
 BY: OLWR