

State Well Report

Part I

Mississippi Department of Environmental Quality
Office of Land and Water Resources
P.O. Box 10631
Jackson, MS 39289-0631
(601) 961-5210
(601) 354-6938 (fax)

For Office Use Only:

Aquifer: Q 43
Well #: _____
L. S. Elevation: _____
E-log #: _____

County: Perry

Permit #: _____

Driller: Coast Water Well Service

Date drilling completed: 12/14/10

State Law requires that this report be prepared by the driller in detail and filed with the Department within 30 days of completion of drilling of the well.

Well Owner Information

Owner Name: Arlen Johnson

Mailing Address: Ashe Nursery Road
Wiggins, Ms.

City _____ State _____ Zip Code _____

Telephone No. (228) 380-4788

Well Location

Latitude: 30° 58' 45.0" Longitude: 89° 07' 31.80"

Method of Lat/Long (circle one): Conventional Survey,

USGS quad, Hand-held GPS, Survey-grade GPS

NW 1/4 NE 1/4 Sec 7 Twn T15 Rng R11W

Distance 16 Miles Direction SW of Nearest Town Beaumont

Well Data

Purpose of Well (circle one) Home Industrial Public Supply Irrigation Fish Culture Other: Hunting Camp

Date well drilling started: 12/14/10 Date well drilling completed: 12/14/10

If flowing, method of flow regulation: Valve N/A Other (describe) _____

Static Water Level: 55 feet above or below (circle one) land surface Date measured: 12/14/10

Method of Measurement (circle one) steel tape electric tape air line other: _____

Hole depth: 122 FT. Well depth: 122 FT. Well grouted to a depth of 10 feet

Type of grout (circle one): Cement Bentonite Mix

Casing length: 112 feet Casing diameter: 2 inches Type of casing: PVC

Screen length: 10 feet Screen diameter: 2 inches Type of screen: PVC

Screen slot size: .006 inches Setting depth: From 112 feet to 122 feet

Type of completion (circle all applicable): Gravel packed Underreamed Telescoped Open hole Natural Development

Other (describe): _____

Top of lap pipe or reduction in casing: N/A feet. If telescoped or more than one screen, describe on back of page

Logs run (circle all applicable): No log run Electric Gamma Ray Density Sonic Neutron Other: _____

Name of organization running log(s): N/A

I certify that the well was drilled, constructed, and completed in accordance with all applicable requirements of the Mississippi Department of Environmental Quality and/or the Mississippi Department of Health regulations and state laws.

Jack Ridgell 0-472

Print Name of Water Well Contractor and License No.

Jack Ridgell
Signature of Water Well Contractor

RECEIVED


DEC 16 2010

BY: OLWR

Q 43

If well telescopes please sketch below and show depths.


Ground Level

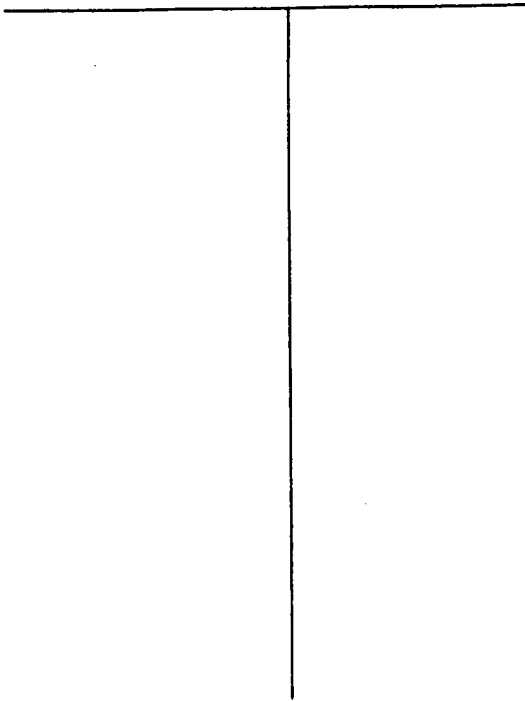

Description of Formations Encountered	From	To
Top Soil	0	2
Orange Clay	2	10
Orange Coarse Sand	10	23
Blue Clay	23	84
Gray Clay w/ streaks of Sand	84	107
Orange Coarse Sand	107	122

If more than one screen, show location of each on sketch

Sketch the property layout and include the following: 1) the well location; 2) any permanent structures on the property that may aid in locating the well; 3) any roads, power lines, or other items that may aid in locating the property and the well; 4) indicate direction.

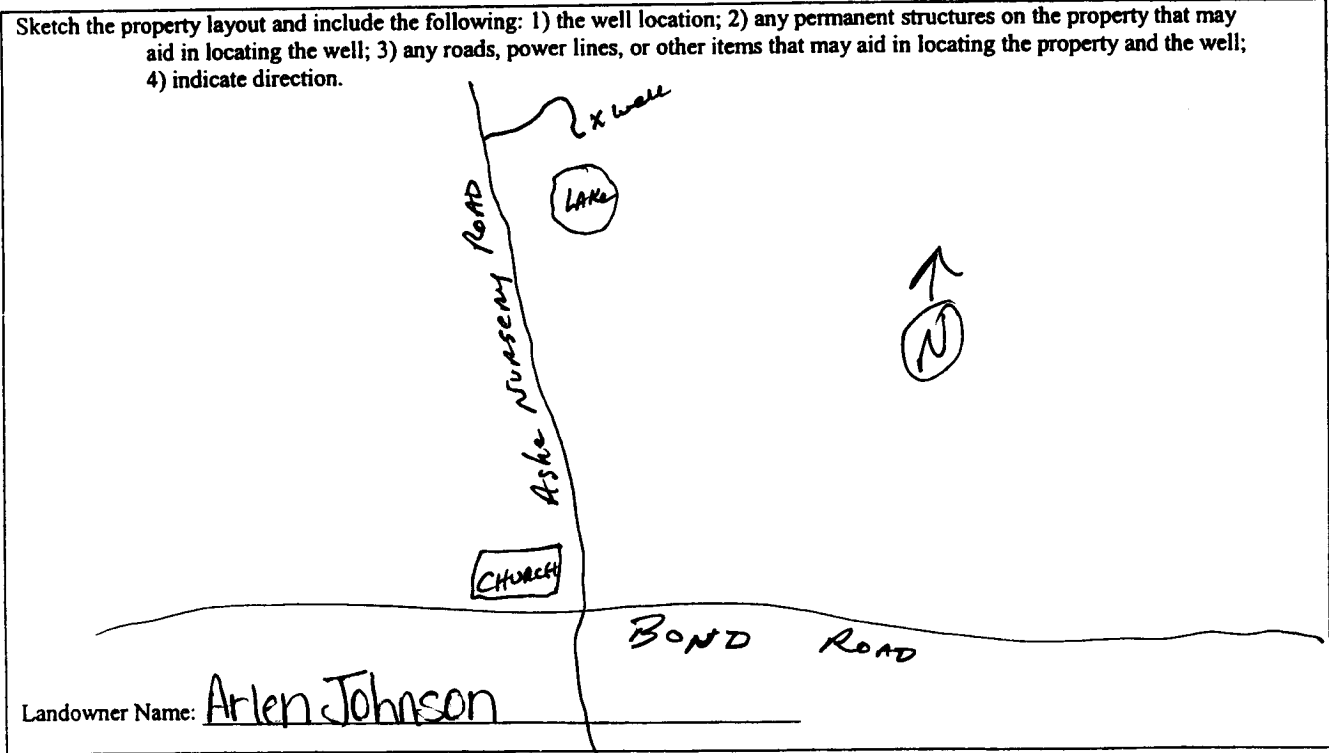

Landowner Name: Arlen Johnson

Signature of Water Well Contractor

RECEIVED
DEC 16 2010
BY: OLWR

STATE WELL REPORT

Part 2

Pump Installer's Completion Report
 Mississippi Department of Environmental Quality
 Office of Land and Water Resources
 P.O. Box 10631
 Jackson, MS 39289-0631
 (601) 961-5210
 (601) 354-6938 (fax)

For Office Use Only:

Aquifer: _____
 Well #: _____
 Elevation: _____

County: Perry
 Permit #: _____
 Driller: Coast Water Wells SRV
 Date completed: 12/14/10

This report should be prepared by the pump installer in detail and filed with the Department within 30 days of the installation of pump.

Well Owner Information	Well Location
Owner Name: <u>Arlen Johnson</u>	Latitude: <u>30° 58' 46.56"</u> Longitude: <u>089° 01' 34.80"</u>
Mailing Address: _____ _____ _____	Method of Lat/Long (circle one): Conventional Survey, USGS quad, <u>Hand-held GPS</u> , Survey-grade GPS
City _____ State _____ Zip Code _____	<u>NW 1/4 NE 1/4</u> Sec <u>7</u> Twn <u>T13</u> Rng <u>R11W</u>
Telephone No. <u>(228) 380-4788</u>	Distance _____ Direction _____ Nearest Town _____ <u>16</u> Miles <u>SW</u> of <u>Beaumont</u>

Pump Type Circle one	Power Type Circle one
Air Lift <input type="radio"/> Jet <input checked="" type="radio"/> Submersible	Diesel Engine <input type="radio"/> Gasoline Engine <input type="radio"/> Natural Gas
Bucket <input type="radio"/> Piston <input type="radio"/> Turbine	<u>Electric Motor</u> <input checked="" type="radio"/> Hand <input type="radio"/> Tractor PTO
Centrifugal <input type="radio"/> Rotary <input type="radio"/> Flowing Well	Windmill <input type="radio"/> Other (specify): _____
Other (specify): _____	Horse Power Rating of Motor: <u>1 HP</u>
Date Pump Installed: <u>12/14/10</u>	Setting Depth: <u>70 FT. Drop Pipe</u> feet
Rated Pump Capacity: <u>8.5</u> Gallons Per Minute	Number of Stages: <u>2</u>

Pump Test Data	Method of Measuring Water Level Circle one
Date Well Tested: <u>12/14/10</u>	<u>Air Line</u> <input checked="" type="radio"/> Electric Measuring Line <input type="radio"/> Steel Tape <input type="radio"/>
Static Water Level (A): <u>55</u> Feet Below Land Surface	Other (specify): _____
Pumping Water Level (B): <u>N/A</u> Feet Below Land Surface	For flowing well, measured shut in head: <u>N/A</u> feet
Drawdown [(B) - (A)]: <u>N/A</u> Feet Below Land Surface	Well yielded <u>18</u> GPM with a drawdown of
Test Pumping Rate: <u>8.5</u> Gallons Per Minute	<u>N/A</u> feet after <u>N/A</u> hours of pumping
Duration of Pump Test (minimum 4 hours): <u>4</u> hours	

I HEREBY CERTIFY that the above statements are true to the best of my knowledge.

Jack Ridgell 0-472 Jack Ridgell
 Print Name of Pump Installer and License No. (if applicable) Signature of Pump Installer

RECEIVED

DEC 16 2010
 BY: OLWR