4	STATE	WELL REPORT	
County: Perry	~	Part 1	For Office Use Only:
/	D	riller's Log	Well #: 🕞 46
Permit #:	Mississippi Departi	ment of Environmental Quality	Aquifer:
Driller: H. Williama		nd and Water Resources P.O. Box 2309	E-Log #:
Date drilling completed:		on, MS 39225-2309	
		601)961-5210 1)360-0535 (fax)	NEVENVEL
State Law requires that this report Department at the above address w	be prepared by the	license holder responsible for the	he work and filed with the P 28 2015
Well Owner Informat			hole Location RV. OWF
(Landowner if borehole is not for		Latitude: 30° 55' 41" N Lor	paitude: 89°.5'32"W
Owner Name: N.G. Hickm	an		
Mailing Address: 101 E. Ben	d Rd): Conventional Survey,
		USGS quad, Hand-held G	
Wigghig Mg City State	39577		28 T 15 R/1W
	Zip Code	<u>6</u> Miles NE o	r Wigains
Telephone No. (601)762-	5343	(Distance) (Direction)	(Nearest Town)
,	Well / B	orehole Data	
Date drilling started: <u>9/14</u> Date	drilling completed:	9/15 Hole depthy 75	Hole diameters
Location of the source of any surface w		ACPA	
Method of dosing and volume of Chlorin		l	
Logs run (circle all applicable); No log ru	un Electric Gamm	na Ray Density Sonic Neutro	n Other:
Name of organization running log(s):	-		
Purpose of borehole (circle one): Water	Well Geotechnie	cal/Geological Investigation	Ground Source Heat Pump
Seism	ic Survey Other (describe)	
If drilling is not rela	ated to water well co	onstruction, skip the remainder	of this block
Purpose of Well (circle all applicable).	Home Industrial	Public Supply Irrigation F	Fish Culture
Other (describe):	_		
If a flowing well, method of flow regula			
Static Water Level: <u>3/</u> feet	[above or below] (circle one)	land surface Date measured	: 9/16
Method of measurement (circle one); St			
Well depth: 75^{-1} Well grouted to a	depth of: <u>10</u> fe	et Type of grout (circle one);	Neat Cement Bentonite Mix
Casing length:	sing diameter:	<u>4</u> inches Type of c	asing: PVC 5-440
Screen length: <u>20</u> feet So	creen diameter:	<u>4 <i>k</i></u> inches Type of s	creen: <u>PVC 6c440</u>
Screen slot size: 0,008inches	Setting depth:	From <u>55</u> feet to	feet
Type of completion (circle all applicable): Gravel packed	Underreamed Open hole	Natural Development
Other (describe):			
Top of lap pipe or reduction in casing:	feet		
If telesco	ped or more than o	ne screen, describe on next pag	e

۲


County: _	Perry
Permit #:	

	or Office Use Only:
Well #:	Q46

The sketch below only required for water wells

If well telescopes, show depths on sketch.

Ground Level

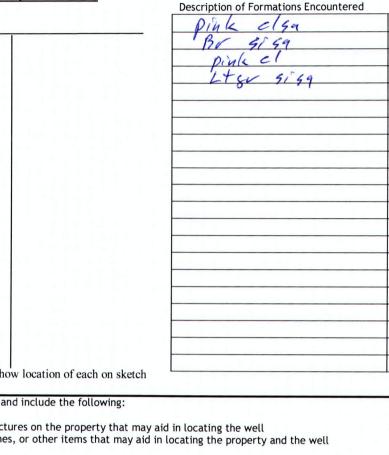

Description of formations encountered must be provided for all wells and boreholes, unless specifically exempted by regulations

Description of Formations Encountered	From (depth)	To (depth)
pink elga	Ground level	20
BV 4159	20	65
professel	65	68
Lter sig	68	75
0 - 1	~	

If more than one screen, show location of each on sketch

 Sketch the property layout and include the following: 1) the well location 2) any permanent structures on the property that may aid in locating the we 3) any roads, power lines, or other items that may aid in locating the property 4) north arrow 	ll ty and the well
E Boud Rd	1
Prince	RECEIVED
	SEP 28 2015
glab well	BY: OLWR
Landowner Name:	House
I HEREBY CERTIFY that the well/borehole was drilled, constructed, and c requirements of the Mississippi Department of Environmental Quality and if applicable, and state laws.	completed in accordance with all applicable I the Mississippi Department of Health regulations,
Heath E. Williams 0-790 9/10/15	Atte
Print Name of Responsible Licensee and License No. 2 Date	Signature of Licensee Form: OLWR-SWR-1A (4/13)

,	STATE WE	LL REPORT	
County: Perry		Part 2	For Office Use O
/ Permit #:		s Completion Report nt of Environmental Quality	well #: Q 46
Driller: H. Williams		and Water Resources	
Date completed: 9/17/15		Box 2309	Aquifer:
Copy information from block on Part 1		MS 39225-2309)961-5210	Aquilet:
		60-0535 (fax)	
This part of the report must be complete	ed by a licensed water we	ell contractor or a licensed pu	np installer. A copy of Pa
of the report must be attached and both Well Owner Informat			<i>within 30 days of well comp</i> .ocation
Owner Name: W: G, Hickn		atitude <u>30°55' 41'' N</u> Lor	_
		-	-
Mailing Address:		ethod of Lat/Long (check one	
		SGS quad, Hand-held G	
<u></u>		<u>VW_14_SE_14, Sec_</u>	
City State	Zip Code	<u> </u>	
Telephone No. ()	(Distance) (Direction)	(Nearest Town)
	Pump Type	(circle one)	<u> </u>
Date Pump Installed:			
	azirod Poplacoment		
Is This Pump (<i>circle one</i>): New Rep Electric Diesel Gasoline Natural Gas Horse Power Rating of Motor: _/, O	Power Type Tractor PTO Windm	ill Other (<i>describe</i>):	
Electric Diesel Gasoline Natural Gas Horse Power Rating of Motor:,0 Date Well Tested:9/[17 Static Water Level (A):/ Fee Drawdown [(B) - (A)]:(0	Power Type Tractor PTO Windm Setting Depth: Pump Test Data for D t Below Land Surface Feet Below Land Surface	ill Other (<i>describe</i>): feet Number Non Flowing Well Duration of Pump Test (<i>minim</i> Pumping Water Level (B): Test Pumping Rate:	of Stages: um 4 hours): /Feet Below Land S / Gallons Per
Electric Diesel Gasoline Natural Gas Horse Power Rating of Motor: Date Well Tested: Static Water Level (A):	Power Type Tractor PTO Windm Setting Depth: Pump Test Data for D t Below Land Surface Feet Below Land Surface Feet Below Land Surface	ill Other (<i>describe</i>): feet Number Non Flowing Well Duration of Pump Test (<i>minim</i> Pumping Water Level (B): Test Pumping Rate: Air line Other (<i>describe</i>):	of Stages: um 4 hours): /Feet Below Land S / Gallons Per
Electric Diesel Gasoline Natural Gas Horse Power Rating of Motor: Date Well Tested: Static Water Level (A): Drawdown [(B) - (A)]: Method of measurement (circle one)	Power Type Tractor PTO Windm Setting Depth: Pump Test Data for D t Below Land Surface Feet Below Land Surface Feet Below Land Surface Feet Below Land Surface Feet Below Land Surface	ill Other (<i>describe</i>): feet Number Non Flowing Well Duration of Pump Test (<i>minim</i> Pumping Water Level (B): Test Pumping Rate: Air line Other (<i>describe</i>):	of Stages: um 4 hours): //Feet Below Land S / O Gallons Per
Electric Diesel Gasoline Natural Gasoline Horse Power Rating of Motor:	Power Type Tractor PTO Windm Setting Depth: Pump Test Data for Below Land Surface Feet Below Land Surface Feet Below Land Surface Reet Tape Electric tape Pump Test Data f	ill Other (<i>describe</i>): feet Number Non Flowing Well Duration of Pump Test (<i>minim</i> Pumping Water Level (B): e Test Pumping Rate: Air line Other (<i>describe</i>): for Flowing Well	of Stages: oum 4 hours): 4Feet Below Land S 1_0 Gallons Per
Electric Diesel Gasoline Natural Gas Horse Power Rating of Motor: Date Well Tested: Static Water Level (A): Drawdown [(B) - (A)]: Method of measurement (<i>circle one</i>)	Power Type Tractor PTO Windm Setting Depth: Pump Test Data for Below Land Surface Feet Below Land Surface Feet Below Land Surface Reet Tape Electric tape Pump Test Data f	ill Other (<i>describe</i>): feet Number Non Flowing Well Duration of Pump Test (<i>minim</i> Pumping Water Level (B): e Test Pumping Rate: Air line Other (<i>describe</i>): for Flowing Well	of Stages: oum 4 hours): 4Feet Below Land S 1_0 Gallons Per
Electric Diesel Gasoline Natural Gas Horse Power Rating of Motor:	Power Type Tractor PTO Windm Setting Depth: Pump Test Data for D t Below Land Surface Feet Below Land Surface Feet Below Land Surface Reel tape Electric tape Pump Test Data f Irawdown of Meter Ins	ill Other (<i>describe</i>): feet Number Non Flowing Well Duration of Pump Test (<i>minim</i> Pumping Water Level (B): Test Pumping Rate: Air line Other (<i>describe</i>): for Flowing Well feet after tallation	of Stages: um 4 hours): //Feet Below Land S // Gallons Per hours of pumping
Electric Diesel Gasoline Natural Gasoline Horse Power Rating of Motor: 0 Date Well Tested: 9 Date Well Tested: 9 Static Water Level (A): Drawdown [(B) - (A)]: Method of measurement (circle one) Measured shut in head:	Power Type Tractor PTO Windm Setting Depth: Pump Test Data for D t Below Land Surface Feet Below Land Surface Feet Below Land Surface Reel tape Electric tape Pump Test Data f Irawdown of Meter Ins	ill Other (<i>describe</i>): feet Number Non Flowing Well Duration of Pump Test (<i>minim</i> Pumping Water Level (B): e Test Pumping Rate: Air line Other (<i>describe</i>): for Flowing Well feet after	of Stages: um 4 hours): //Feet Below Land S // Gallons Per hours of pumping
Electric Diesel Gasoline Natural Gas Horse Power Rating of Motor:	Power Type Tractor PTO Windm Setting Depth: Pump Test Data for Below Land Surface Feet Below Land Surface Feet Below Land Surface Reel tape Electric tape Pump Test Data for Meter Inst Mater Inst Mat	ill Other (<i>describe</i>): feet Number Non Flowing Well Duration of Pump Test (<i>minim</i> Pumping Water Level (B): Test Pumping Rate: Air line Other (<i>describe</i>): for Flowing Well feet after tallation Meter Serial Number:	of Stages: um 4 hours): //Feet Below Land S / Gallons Per
Electric Diesel Gasoline Natural Gas Horse Power Rating of Motor:	Power Type Tractor PTO Windm Setting Depth: Pump Test Data for D t Below Land Surface Feet Below Land Surface Meter Inst	ill Other (<i>describe</i>):	of Stages: um 4 hours): HFeet Below Land S LOGallons Per hours of pumping SEP 2 8
Electric Diesel Gasoline Natural Gas Horse Power Rating of Motor:	Power Type Tractor PTO Windm Setting Depth: Pump Test Data for D t Below Land Surface Feet Below Land Surface Feet Below Land Surface Reel tape Electric tape Pump Test Data f Irawdown of Meter Inst Mater Inst Mate	ill Other (<i>describe</i>):	of Stages: um 4 hours): HFeet Below Land S LO Gallons Per hours of pumping SEP 2 8
Electric Diesel Gasoline Natural Gas Horse Power Rating of Motor:	Power Type Tractor PTO Windm	ill Other (<i>describe</i>):	of Stages: um 4 hours): HFeet Below Land S LO Gallons Per hours of pumping SEP 2 8
Electric Diesel Gasoline Natural Gas Horse Power Rating of Motor:	Power Type Tractor PTO Windm Setting Depth: Pump Test Data for	ill Other (<i>describe</i>):	of Stages: um 4 hours): //Feet Below Land S // Gallons Per hours of pumping SEP 2 8
Electric Diesel Gasoline Natural Gas Horse Power Rating of Motor:	Power Type Tractor PTO Windm Setting Depth: Pump Test Data for	ill Other (<i>describe</i>):	of Stages: um 4 hours): //Feet Below Land S // Gallons Per hours of pumping SEP 2 8 SEP 2 8 Idd to manufacturer stand
Electric Diesel Gasoline Natural Gas Horse Power Rating of Motor:	Power Type Tractor PTO Windm	ill Other (describe):	of Stages: um 4 hours): //Feet Below Land // Gallons Per hours of pumping SEP 2 SEP 2 Compared to manufacturer stand

Form: OLWR-SWR-1B (4/13)