

Perry
Q 200
6-2-76

MISSISSIPPI
BOARD OF WATER COMMISSIONERS
416 North State Street
132 Jackson, Mississippi 39201

WATER WELL DRILLERS LOG

6-2 date well completed 1976 firm name Harold Anderson Perry county well located

LANDOWNER:
George Lopez
(mailing address)

WELL LOCATION:
sec. 34 T 1 S R 11 W
6 miles NE of ridge ln
(distance) (direction) (nearest town)

WELL PURPOSE: HOME
(home, irrigation, municipal, industrial)

- WELL COMPLETION DATA:
- (1) diameter (inches) 9
 - (2) total depth (feet) 105
 - (3) static water level (feet) 25 below above top of ground.
 - (4) casing Plastic 100'
(material) (depth)
 - (size) if telescope see back.
 - (5) screen 3" 100'
(length) (depth to top)
 - 2" Plastic
(size) (material)
 - (6) pump 1 10
(HP) (yield gpm)
 - Elect
(type power)
 - (7) electric log no
(yes or no)
 - (organization running log)
 - (8) how well bottom plugged Capped

description of formations encountered	from	to
<u>Top Soil</u>	<u>0</u>	<u>4</u>
<u>Sandy clay</u>	<u>4</u>	<u>92</u>
<u>Thin sand</u>	<u>92</u>	<u>97</u>
<u>Clay</u>	<u>44</u>	<u>97</u>
<u>Coarse sand</u>	<u>47</u>	<u>105</u>

RECEIVED


JUL - 2 1976

MISS. BD. OF WATER COMM

DRILLERS REMARKS:

If well telescopes please sketch and show depths.

GROUND LEVEL

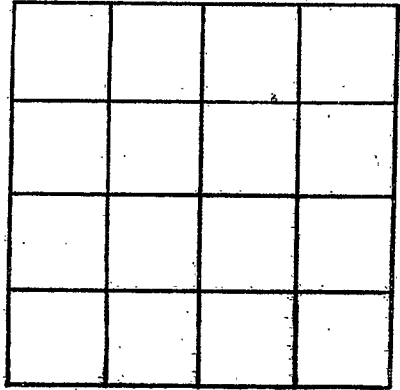

SECTION _____

Please indicate well location X.

ADDITIONAL INFORMATION

If more than one screen, show locations of each on sketch.