

PERRY
 Q 2003
 10-27-78

MISSISSIPPI
 BOARD OF WATER COMMISSIONERS
 416 North State Street
 Jackson, Mississippi 39201

WATER WELL DRILLERS LOG

10-27-78 date well completed
 78 Parnell Anderson Perry firm name
 county well located

LANDOWNER:
 C. B. Whittles
 (mailing address)

description of formations encountered	from	to
Top Soil	0	2
Sandy Clay	2	16
Course Sand	16	39

WELL LOCATION:
 sec. 13 T. 1 N. R. 11 W. S. W.
 1.2 miles NE of Wiggins
 (distance) (direction) (nearest town)

WELL PURPOSE: HOME
 (home, irrigation, municipal, industrial)

WELL COMPLETION DATA:

(1) diameter (inches) 2"

(2) total depth (feet) 39'

(3) static water level (feet) 33' below top of ground.

(4) casing Plastic 34' (material) (depth)
 If telescope see back.

(5) screen 5" 34' (length) (depth to top)
 2" Plastic (size) (material)

(6) pump 1 8 (HP) (yield gpm)
 Elect (type power)

(7) electric log no (yes or no)

(organization running log)

(8) how well bottom plugged capped


RECEIVED
 NOV - 1 1978

MISS. BD. OF WATER COMMISSIONERS

DRILLERS REMARKS:

If well telescopes please sketch and show depths.

GROUND LEVEL

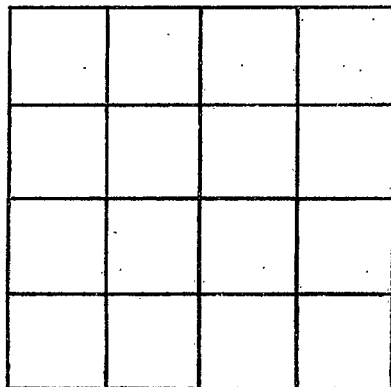

SECTION _____

Please indicate well location X.

ADDITIONAL INFORMATION

If more than one screen,
show locations of each on sketch.