

PERRY
 Q 2004
 9-18-78

MISSISSIPPI
 BOARD OF WATER COMMISSIONERS
 416 North State Street
 Jackson, Mississippi 39201

WATER WELL DRILLERS LOG

9-18-78 date well completed 1978 firm name *Perry* county well located *Perry*

LANDOWNER:
Clent Smith
 (mailing address)

description of formations encountered	from	to
<i>Top Soil</i>	<i>0</i>	<i>2</i>
<i>Sandy clay</i>	<i>2</i>	<i>28</i>
<i>Course Sand</i>	<i>28</i>	<i>84</i>

WELL LOCATION:
 sec *29* T *1* S R *11* W
1 1/2 miles *E* of *Forest Cove Line*
 (distance) (direction) (nearest town)

WELL PURPOSE: *HOME*
 (home, irrigation, municipal, industrial)

WELL COMPLETION DATA:

(1) diameter (inches) *2"*

(2) total depth (feet) *84*

(3) static water level (feet) *38* below top of ground.

(4) casing *Plastic* *79'*
 (material) (depth)

(size) If telescope see back.

(5) screen *5"* *79'*
 (length) (depth to top)

2" *Plastic*
 (size) (material)

(6) pump *1* *12*
 (HP) (yield gpm)

Elect
 (type power)

(7) electric log *NO*
 (yes or no)

(organization running log)


(8) how well bottom plugged *Capped*

DRILLERS REMARKS:

RECEIVED
 OCT 12 1978

If well telescopes please sketch and show depths.

GROUND LEVEL

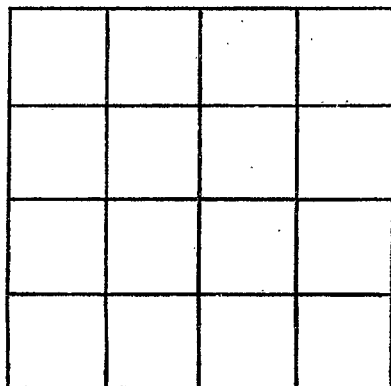

SECTION _____

Please indicate well location X.

ADDITIONAL INFORMATION

If more than one screen,
show locations of each on sketch.