

PERRY
 2005
 6/13/78

MISSISSIPPI
 BOARD OF WATER COMMISSIONERS
 416 North State Street
 Jackson, Mississippi 39201

WATER WELL DRILLERS LOG

PERRY

6-23-1978 Dunnell Contractors Forest
 date well completed firm name county well located


LANDOWNER:
J. A. Gilbert
 (mailing address)

description of formations encountered	from	to
<u>Top Soil</u>	<u>0</u>	<u>3</u>
<u>fine sand</u>	<u>3</u>	<u>45</u>
<u>collapse level</u>	<u>45</u>	<u>76</u>

WELL LOCATION:
 sec. 38 T. 1 N R. 11 E
8 miles SE of Brooklyn
 (distance) (direction) (nearest town)

WELL PURPOSE: HOME
 (home, irrigation, municipal, industrial)

- WELL COMPLETION DATA:
- (1) diameter (inches) 2"
 - (2) total depth (feet) 76
 - (3) static water level (feet) 30 below top of ground.
 - (4) casing Plastic, 71'
 (material) (depth)
 - (size) If telescope see back.
 - (5) screen 5', 71'
 (length) (depth to top)
 - 2", Plastic
 (size) (material)
 - (6) pump 1, 10
 (HP) (yield gpm)
 - Elect
 (type power)
 - (7) electric log no
 (yes or no)
 - (organization running log)
 - (8) how well bottom plugged Capped

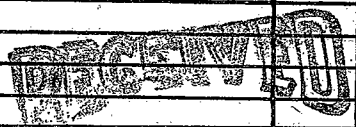

JUL - 7 1978

DRILLERS REMARKS:

MISS. BD. OF WATER COMMISSIONERS

If well telescopes please sketch and show depths.

GROUND LEVEL

SECTION _____

Please indicate well location X.

ADDITIONAL INFORMATION

If more than one screen,
show locations of each on sketch.