

Perry  
 11 2000  
 10-5-79

MISSISSIPPI  
 BOARD OF WATER COMMISSIONERS  
 416 North State Street  
 Jackson, Mississippi 39201

WATER WELL DRILLERS LOG

10-5-79  
 date well completed

1979 Carroll Anderson  
 firm name

Perry  
 county well located

LANDOWNER:	description of formations encountered	from	to
<u>John Misdale</u>	<u>Top Soil</u>	<u>0</u>	<u>3</u>
(mailing address)	<u>Fin Sand</u>	<u>3</u>	<u>35</u>
WELL LOCATION:	<u>Clay</u>	<u>35</u>	<u>50</u>
sec. <u>19</u> T. <u>1</u> S. R. <u>11</u> E. of <u>Wiggins</u>	<u>Course Sand</u>	<u>50</u>	<u>85</u>
<u>5-1/2</u> miles (distance) <u>N</u> (direction) (nearest town)			
WELL PURPOSE: <u>HOME</u> (home, irrigation, municipal, industrial)			
WELL COMPLETION DATA:			
(1) diameter (inches) <u>2"</u>			
(2) total depth (feet) <u>85'</u>			
(3) static water level (feet) <u>41'</u> below top of ground.			
(4) casing <u>Plastic</u> , <u>80'</u> (material) (depth)			
(size) If telescope see back.			
(5) screen <u>5'</u> , <u>80'</u> (length) (depth to top)			
<u>2"</u> , <u>Plastic</u> (size) (material)			
(6) pump <u>1</u> (HP) <u>11</u> (yield gpm)			
<u>Elect</u> (type power)			
(7) electric log <u>no</u> (yes or no)			
(organization running log)			
(8) how well bottom plugged <u>Capped</u>			
DRILLERS REMARKS:			


DEPT. OF NATURAL RESOURCES  
 BUREAU OF LAND & WATER RESOURCES

NOV 20 1979

RECEIVED

If well telescopes please sketch and show depths.

GROUND LEVEL

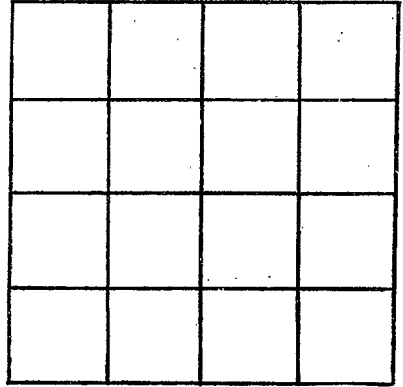

SECTION \_\_\_\_\_

Please indicate well location X.

ADDITIONAL INFORMATION

If more than one screen,  
show locations of each on sketch.