

PERRY

MISSISSIPPI
BOARD OF WATER COMMISSIONERS
416 North State Street
Jackson, Mississippi 39201

Q 2008
7/24/80

WATER WELL DRILLERS LOG

7-24 1980 Pernell Robinson Perry
date well completed firm name county well located

LANDOWNER:	description of formations encountered	from	to
<u>Avery Simons</u>	<u>Top Soil</u>	<u>0</u>	<u>3</u>
(mailing address)	<u>Clay</u>	<u>3</u>	<u>18</u>
WELL LOCATION:	<u>Int Sand</u>	<u>18</u>	<u>79</u>
sec. <u>30</u> T <u>1</u> R <u>11</u>	<u>Course Sand</u>	<u>79</u>	<u>94</u>
S <u>5</u> miles <u>N</u> of <u>W. Logan</u>			
(distance) (direction) (nearest town)			
WELL PURPOSE: <u>HOME</u> (home, irrigation, municipal, industrial)			
WELL COMPLETION DATA:			
(1) diameter (inches) <u>2"</u>			
(2) total depth (feet) <u>94'</u>			
(3) static water level (feet) <u>57'</u> below top of ground.			
(4) casing <u>Plastic</u> <u>89'</u> (material) (depth)			
If telescope see back. (size)			
(5) screen <u>5"</u> <u>89'</u> (length) (depth to top)			
<u>2"</u> <u>Plastic</u> (size) (material)			
(6) pump <u>1</u> <u>10</u> (HP) (yield gpm)			
<u>Elect</u> (type power)			
(7) electric log <u>no</u> (yes or no)			
(organization running log)			
(8) how well bottom plugged <u>Capped</u>			
DRILLERS REMARKS:			


DEPT. OF NATURAL RESOURCES
BUREAU OF LAND & WATER RESOURCES

AUG 8 1980

RECEIVED

If well telescopes please
sketch and show depths.

GROUND LEVEL

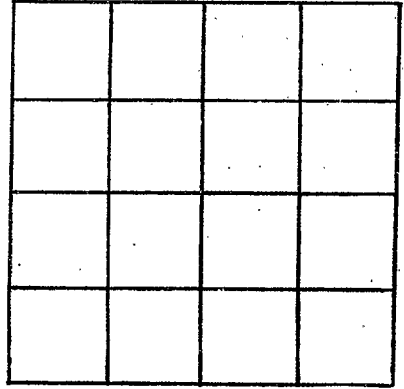

SECTION _____

Please indicate well location X.

ADDITIONAL INFORMATION

If more than one screen,
show locations of each on sketch.