

Perry  
 Q 2009  
 5-13-80

MISSISSIPPI  
 BOARD OF WATER COMMISSIONERS  
 416 North State Street  
 Jackson, Mississippi 39201

WATER WELL DRILLERS LOG

4-14 1980 Braden Pump & Well Perry  
 date well completed firm name county well located  
 Ser. Inc

LANDOWNER: John Hayne  
 Rt. 1  
 Brookly, MS  
 (mailing address)

description of formations encountered	from	to
Clay	0	170
Sand	170	220

WELL LOCATION:  
 sec. 11 T. 1 S. R. 11 W.  
 7 miles NE of Wiggins  
 (distance) (direction) (nearest town)

WELL PURPOSE: none  
 (home, irrigation, municipal, industrial)

WELL COMPLETION DATA:

- (1) diameter (inches) 2"
- (2) total depth (feet) 220'
- (3) static water level (feet) 25 below top of ground.
- (4) casing PVC, 220' (material), (depth)  
 2" (size) If telescope see back.
- (5) screen 10' , 200' (length), (depth to top)  
 2" (size), ms PVC underbar (material).
- (6) pump 1 (HP) 10 (yield gpm)  
 D30 (type power)
- (7) electric log NO (yes or no)  
 (organization running log)
- (8) how well bottom plugged 2" sand shark

DEPT. OF NATURAL RESOURCES  
 BUREAU OF LAND & WATER RESOURCES


MAY 7 1980

RECEIVED

DRILLERS REMARKS:  
 10' tail pipe

If well telescopes please sketch and show depths.

GROUND LEVEL

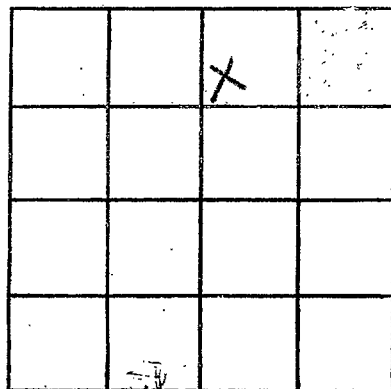

SECTION 11

Please indicate well location X.

ADDITIONAL INFORMATION

If more than one screen, show locations of each on sketch.