

Perry  
Q 2010  
5-13-80

MISSISSIPPI  
BOARD OF WATER COMMISSIONERS  
416 North State Street  
Jackson, Mississippi 39201

WATER WELL DRILLERS LOG

4-16 1980 Broden Pump-Well Perry  
date well completed firm name county well located

LANDOWNER:  
Lorenza McDowell  
P.O. Box 134  
Brooklyn MS  
(mailing address)

description of formations encountered	from	to
Clay Sand	0	170
	170	220

WELL LOCATION:  
sec. 11 T. 1 S. R. 11 W.  
7 miles NE of Wiggins  
(distance) (direction) (nearest town)

WELL PURPOSE: Home  
(home, irrigation, municipal, industrial)

- WELL COMPLETION DATA:
- (1) diameter (inches) 2"
  - (2) total depth (feet) 220'
  - (3) static water level (feet) 25 below top of ground.
  - (4) casing PC, total!  
(material) (depth)  
2" (size) if telescope see back.
  - (5) screen 10' 180'  
(length) (depth to top)  
2" (size) PC under
  - (6) pump 1 10  
(HP) (yield gpm)  
115 (type power)
  - (7) electric log NO  
(yes or no)
- (organization running log)

DEPT. OF NATURAL RESOURCES  
BUREAU OF LAND & WATER RESOURCES

MAY 7 - 1980


(8) how well bottom plugged  
2 SAND SHARK

DRILLERS REMARKS:  
30' tail pipe

RECEIVED

If well telescopes please sketch and show depths.

GROUND LEVEL

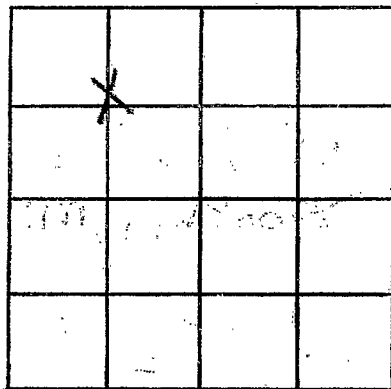

SECTION 11

Please indicate well location X.

ADDITIONAL INFORMATION

If more than one screen,  
show locations of each on sketch.