

Perry
Q 2011
3-4-80

MISSISSIPPI
BOARD OF WATER COMMISSIONERS
416 North State Street
Jackson, Mississippi 39201

WATER WELL DRILLERS LOG

3-4 date well completed 1980 firm name Parnell W. Adams Perry county well located

LANDOWNER:

James Williamson

description of formations encountered

Top Soil

from 0 to 5

(mailing address)

Clay

2 22

WELL LOCATION:

sec. 31 T. 1 S. R. 21 E. W. 6 miles S of Brookhaven (distance) (direction) (nearest town)

Coarse Sand

25 84

WELL PURPOSE: HOME
(home, irrigation, municipal, industrial)

WELL COMPLETION DATA:

- (1) diameter (inches) 5"
- (2) total depth (feet) 84'
- (3) static water level (feet) 52' below top of ground.
- (4) casing Plastic, 79' (material) (depth)

(size) If telescope see back.

- (5) screen 5', 79' (length) (depth to top)
- 5", Plastic (size) (material)

- (6) pump 1, 10 (HP) (yield gpm)
- Elect (type power)

- (7) electric log no (yes or no)

(organization running log)

- (8) how well bottom plugged Capped

DRILLERS REMARKS:


DEPT. OF NATURAL RESOURCES
BUREAU OF WATER RESOURCES

APR 29 1980

RECEIVED

If well telescopes please sketch and show depths.

GROUND LEVEL

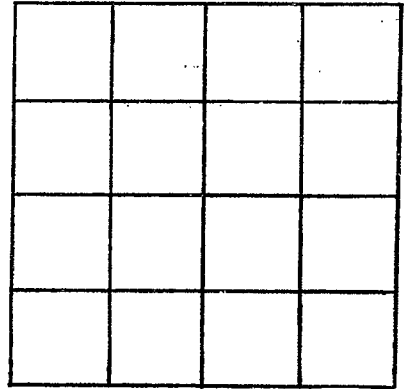

SECTION _____

Please indicate well location X.

ADDITIONAL INFORMATION

If more than one screen,
show locations of each on sketch.