

PERRY

MISSISSIPPI
BOARD OF WATER COMMISSIONERS
416 North State Street
Jackson, Mississippi 39201

WATER WELL DRILLERS LOG

Q 202
3-11-80

3-11
date well completed

1980 Braden Pump Well Perry

Service, Inc
firm name

county well located

LANDOWNER: LaVelle Lee

description of formations encountered

from

to

RT 1, Box 133

Brooklyn, MS
(mailing address)

Clay
Sand

0 30

30 40

WELL LOCATION:

sec. 11 T 1 S R 11 W
1/2 miles S of Stephens
(distance) (direction) (nearest town)

Clay
Sand
Clay

40 55

55 180

180 200

WELL PURPOSE:

(home, irrigation, municipal, industrial)

WELL COMPLETION DATA:

(1) diameter (inches) 2"
(2) total depth (feet) 200'
(3) static water level (feet) _____
top of ground. below/above

(4) casing PVC total
(material) (depth)
2" if telescope see back.
(size)

(5) screen 10' 165'
(length) (depth to top)
2" 005 PVC under
(size) (material)

(6) pump 1 10
(HP) (yield gpm)
110
(type power)

(7) electric log NO
(yes or no)
(organization running log)


(8) how well bottom plugged
2" sand shark

DRILLERS REMARKS:
25' tail pipe

MISSISSIPPI DEPT. OF NATURAL RESOURCES
BUREAU OF LAND & WATER RESOURCES
JUN 25 1980
RECEIVED

If well telescopes please sketch and show depths.

GROUND LEVEL

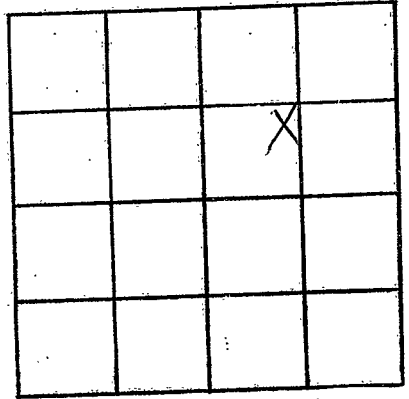

SECTION 11

Please indicate well location X.

ADDITIONAL INFORMATION

If more than one screen, show locations of each on sketch.