

Perry
Q 2013
12/5/81

MISSISSIPPI
BOARD OF WATER COMMISSIONERS
416 North State Street
Jackson, Mississippi 39201

WATER WELL DRILLERS LOG

Perry
Stone

Dec 5 1981 date well completed
Pamela Anderson firm name
Stone county well located

LANDOWNER: Stanley Blair	description of formations encountered	from	to
Pt 3 Box 210 A	Top soil	0	3
Wiggins Ms 39549 (mailing address)	Clay	3	24
	Sand	24	38
	Clay	38	60
	Sand	60	92
WELL LOCATION:			
sec 29 T 1 R 11 S			
8 miles N of Wiggins (distance) (direction) (nearest town)			
WELL PURPOSE: Home (home, irrigation, municipal, industrial)			
WELL COMPLETION DATA:			
(1) diameter (inches) 2"			
(2) total depth (feet) 92'			
(3) static water level (feet) 19 below top of ground.			
(4) casing PVC 87' (material) (depth)			
If telescope see back. (size)			
(5) screen 51 87' (length) (depth to top)			
2" PVC (size) (material)			
(6) pump 1 12 (HP) (yield gpm)			
Electric (type power)			
(7) electric log NO (yes or no)			
(organization running log)			
(8) how well bottom plugged Capped			
DRILLERS REMARKS:			


DEPT. OF NATURAL RESOURCES
BUREAU OF LAND & WATER RESOURCES

DEC 30 1981

RECEIVED

If well telescopes please sketch and show depths.

GROUND LEVEL

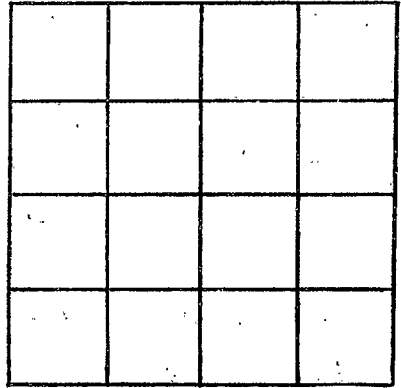

SECTION _____

Please indicate well location X.

ADDITIONAL INFORMATION

If more than one screen,
show locations of each on sketch.