

MISSISSIPPI DEPARTMENT OF NATURAL RESOURCES

Bureau of Land and Water Resources

Southport Mall

P.O. Box 10631

Jackson, Mississippi 39209

WATER WELL DRILLERS LOG

Perry
Q 2014
7-24-81

July 24 1981 date well completed

Parnell Anderson firm name

Perry county well located

LANDOWNER: Joe Simon

Rt 3 Box 211

Wiggins Ms 39549 (mailing address)

description of formations encountered	from	to
Top Soil	0	3
Clay	3	26
Fine Sand	26	52
Clay	52	94
Fine Sand	94	110
Coarse Sand	112	124

WELL LOCATION:

sec 30 T 1 N R 11 E

8 miles NE of Wiggins (distance) (direction) (nearest town)

WELL PURPOSE: Home (home, irrigation, municipal, industrial)

WELL COMPLETION DATA:

(1) diameter (inches) 2"

(2) total depth (feet) 124"

(3) static water level (feet) 60' below top of ground

(4) casing PVC 119' (material) (depth)

(size) If telescope see back.

(5) screen 5' 119' (length) (depth to top)

2" PVC (size) (material)

(6) pump 1 (HP) 8 (yield gpm)

Electric (type power)

(7) electric log NO (yes or no)


(organization running log)

(8) how well bottom plugged Capped

DRILLERS REMARKS:

If well telescopes please sketch and show depths.

GROUND LEVEL

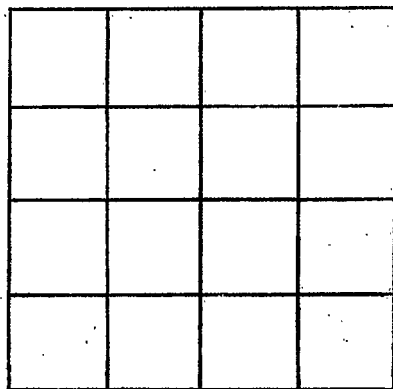

SECTION _____

Please indicate well location X.

ADDITIONAL INFORMATION

If more than one screen,
show locations of each on sketch.