

MISSISSIPPI DEPARTMENT OF NATURAL RESOURCES

Bureau of Land and Water Resources

Southport Mall

P.O. Box 10631

Jackson, Mississippi 39209

WATER WELL DRILLERS LOG

PERRY  
Q 2015  
4/14/81

April 14 1981  
 date well completed

81 Parnell Anderson  
 firm name

Perry Stone  
 county well located

LANDOWNER: Audrey Walter  
Rt 3  
Wiggins Ms  
 (mailing address)

description of formations encountered	from	to
<u>Top Soil</u>	<u>0</u>	<u>2</u>
<u>sand</u>	<u>2</u>	<u>22</u>
<u>clay</u>	<u>22</u>	<u>38</u>
<u>sand</u>	<u>38</u>	<u>64</u>

WELL LOCATION:  
 sec 25 T. 1 N. R. 11 E.  
12 miles N of Wiggins  
 (distance) (direction) (nearest town)


WELL PURPOSE: Home  
 (home, irrigation, municipal, industrial)

- WELL COMPLETION DATA:
- (1) diameter (inches) 2"
  - (2) total depth (feet) 64'
  - (3) static water level (feet) 40' below above top of ground.
  - (4) casing PVC, 59'  
 (material) (depth)  
 (size) if telescope see back.
  - (5) screen 5', 59'  
 (length) (depth to top)  
2", PVC  
 (size) (material)
  - (6) pump 1, 11  
 (HP) (yield gpm)  
Electric  
 (type power)
  - (7) electric log No  
 (yes or no)

(organization running log)


(8) how well bottom plugged Capped

DRILLERS REMARKS:

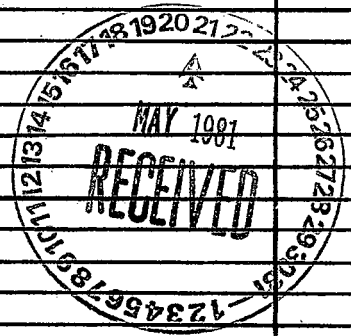

If well telescopes please sketch and show depths.

GROUND LEVEL

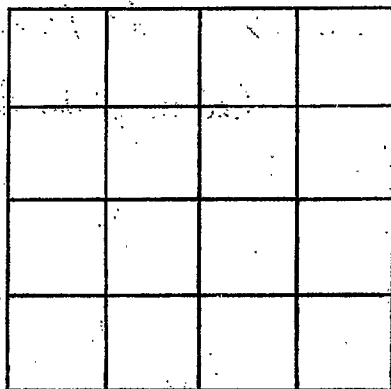

SECTION \_\_\_\_\_

Please indicate well location X.

ADDITIONAL INFORMATION

If more than one screen, show locations of each on sketch.