

MISSISSIPPI DEPARTMENT OF NATURAL RESOURCES

Bureau of Land and Water Resources

Southport Mall

P.O. Box 10631

Jackson, Mississippi 39209

WATER WELL DRILLERS LOG

PERRY  
Q 2046  
1/23/81

Jan 23 1981 date well completed  
Larnell Anderson Perry firm name  
Perry county well located

LANDOWNER: Harry Lawson  
Rt 3  
Wiggins, Ms  
 (mailing address)

description of formations encountered	from	to
<u>Top Soil</u>	<u>0</u>	<u>3</u>
<u>Sand</u>	<u>3</u>	<u>28</u>
<u>Clay</u>	<u>28</u>	<u>50</u>
<u>Sand Fine</u>	<u>50</u>	<u>75</u>
<u>Coarse sand</u>	<u>75</u>	<u>102</u>

WELL LOCATION:  
 sec. 20 T 1 N R 11 E  
11 miles N of Wiggins  
 (distance) (direction) (nearest town)

WELL PURPOSE: home  
 (home, irrigation, municipal, industrial)

- WELL COMPLETION DATA:
- (1) diameter (inches) 2"
  - (2) total depth (feet) 102'
  - (3) static water level (feet) 50 below top of ground.
  - (4) casing PVC 94'  
 (material) (depth)
  - (size) if telescope see back.
  - (5) screen 5' 97'  
 (length) (depth to top)
  - 2" PVC  
 (size) (material)
  - (6) pump 1 10  
 (HP) (yield gpm)
  - Electric  
 (type power)
  - (7) electric log NO  
 (yes or no)

(organization running log)

(8) how well bottom plugged Yes

DRILLERS REMARKS:


DEPT. OF NATURAL RESOURCES  
 BUREAU OF LAND & WATER RESOURCES

MAY 18 1981

RECEIVED

If well telescopes please  
sketch and show depths.

GROUND LEVEL

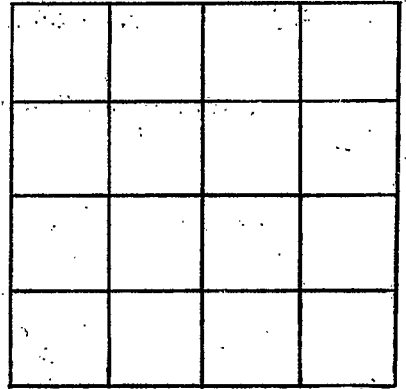

SECTION \_\_\_\_\_

Please indicate well location X.

ADDITIONAL INFORMATION

If more than one screen,  
show locations of each on sketch.