

MISSISSIPPI DEPARTMENT OF NATURAL RESOURCES

Bureau of Land and Water Resources

Southport Mall

P.O. Box 10631

Jackson, Mississippi 39209

WATER WELL DRILLERS LOG

Perry
Q
207

4-21 19*83*
 date well completed

Frank Price
 firm name

Perry
 county well located

LANDOWNER:	description of formations encountered	from	to
<i>Chen Chapman</i>	<i>Top Soil</i>	<i>0</i>	<i>2</i>
(mailing address)	<i>Red Clay</i>	<i>2</i>	<i>12</i>
WELL LOCATION:	<i>Clay</i>	<i>12</i>	<i>45'</i>
sec <i>31</i> T <i>1</i> S R <i>11</i> W	<i>Flint Sand</i>	<i>45</i>	<i>63</i>
<i>3 1/2</i> miles <i>N</i> of <i>Wiggins</i>	<i>Course Sand</i>	<i>63</i>	<i>77</i>
(distance) (direction) (nearest town)			
WELL PURPOSE: <i>HOME</i> (home, irrigation, municipal, industrial)			
WELL COMPLETION DATA:			
(1) diameter (inches) <i>2"</i>			
(2) total depth (feet) <i>77</i>			
(3) static water level (feet) <i>40</i> below top of ground.			
(4) casing <i>Plastic, 92'</i> (material) (depth)			
(size) if telescope see back.			
(5) screen <i>5"</i> , <i>92'</i> (length) (depth to top)			
<i>2"</i> , <i>Plastic</i> (size) (material)			
(6) pump <i>1</i> , <i>10</i> (HP) (yield gpm)			
<i>Elect</i> (type power)			
(7) electric log <i>no</i> (yes or no)			
(organization running log)			
(8) how well bottom plugged <i>Back wash valve</i>			

DEPT. OF NATURAL RESOURCES
 BUREAU OF LAND & WATER RESOURCES


MAY 18 1983

RECEIVED

DRILLERS REMARKS:

If well telescopes please sketch and show depths.

GROUND LEVEL

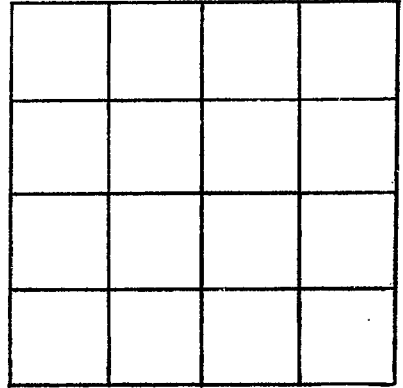

SECTION _____

Please indicate well location X.

ADDITIONAL INFORMATION

If more than one screen,
show locations of each on sketch.