

MISSISSIPPI DEPARTMENT OF NATURAL RESOURCES

Bureau of Land and Water Resources

Southport Mall

P.O. Box 10631

Jackson, Mississippi 39209

WATER WELL DRILLERS LOG

PERRY
Q
2018

Dec 8

1984 Farnell Anderson Perry

date well completed

firm name

county well located

LANDOWNER: Beatrice McCloud
Brooklyn Ms

(mailing address)

WELL LOCATION:

sec. 34 T 1 N R 11 W
10 miles S.E. of Brookhaven
(distance) (direction) (nearest town)

WELL PURPOSE: home
(home, irrigation, municipal, industrial)

WELL COMPLETION DATA:

- (1) diameter (inches) 2"
- (2) total depth (feet) 69'
- (3) static water level (feet) 57' below top of ground.
- (4) casing P.V.C., 64'
(material) (depth)

If telescope see back.

- (5) screen 5' 64'
(length) (depth to top)
- 2" P.V.C.
(size) (material)

- (6) pump 1 HP
(HP) (yield gpm)
- Electric
(type power)

- (7) electric log NO
(yes or no)

(organization running log)

- (8) how well bottom plugged Capped

description of formations encountered	depth	
	from	to
Top Soil	0	2
Clay	3	19
Sand	19	32
Clay	32	48
Sand	48	69


RECEIVED
JUN 17 1986

Department of Natural Resources
Bureau of Land and Water

DRILLERS REMARKS:

If well telescopes please sketch and show depths.

GROUND LEVEL

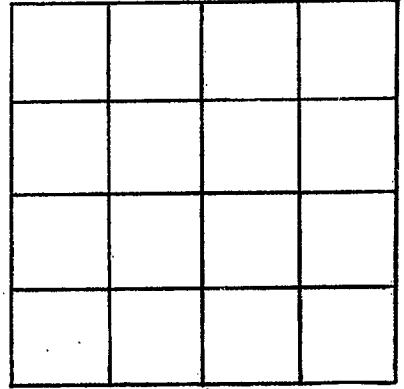

SECTION _____

Please indicate well location X.

ADDITIONAL INFORMATION

If more than one screen,
show locations of each on sketch.