

MISSISSIPPI DEPARTMENT OF NATURAL RESOURCES

Bureau of Land and Water Resources

Southport Mall

P.O. Box 10631

Jackson, Mississippi 39209

WATER WELL DRILLERS LOG

Perry
 20A

7-11
 date well completed

1985 Frank Price Perry
 firm name

county well located

LANDOWNER:

Charles Knight

(mailing address)

WELL LOCATION:

sec 29 T 1 S R 11 E W. 5 miles N WIGGINS
 (distance) (direction) (nearest town)

description of formations encountered

description of formations encountered	from	to
Top Soil	0	2
Sandy Clay	2	28
Clay	28	62
Course Sand	62	83'

WELL PURPOSE:

HOME
 (home, irrigation, municipal, industrial)

WELL COMPLETION DATA:

- (1) diameter (inches) 2"
- (2) total depth (feet) 83'
- (3) static water level (feet) 50' below top of ground.
- (4) casing PVC 78'
 (material) (depth)
- (size) If telescope see back.
- (5) screen 5" 78'
 (length) (depth to top)
- 2" PVC
 (size) (material)
- (6) pump 1 10
 (HP) (yield gpm)
- Elect
 (type power)
- (7) electric log no
 (yes or no)

(organization running log)

(8) how well bottom plugged
 B W V

DRILLERS REMARKS:


RECEIVED

NOV 19 1985

Department of Natural Resources
 Bureau of Land & Water Resources

If well telescopes please
sketch and show depths.

GROUND LEVEL

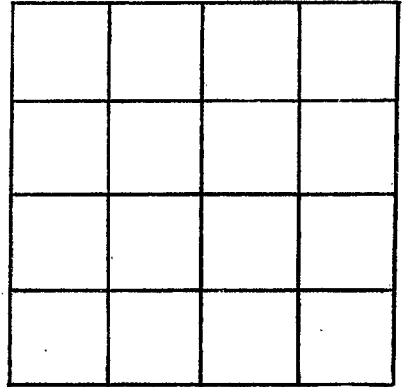

SECTION _____

Please indicate well location X.

ADDITIONAL INFORMATION

If more than one screen,
show locations of each on sketch.