

MISSISSIPPI DEPARTMENT OF NATURAL RESOURCES

Bureau of Land and Water Resources

Southport Mall

P.O. Box 10631

Jackson, Mississippi 39209

WATER WELL DRILLERS LOG

Perry

Perry
Q 2020

1-30 19*87* *Frank Rice* *Perry*
 date well completed firm name county well located

LANDOWNER:
Earl Pike
 (mailing address)

description of formations encountered	from	to
<i>Top Soil</i>	<i>0</i>	<i>3</i>
<i>Clay</i>	<i>3</i>	<i>86</i>
<i>Coarse Sand</i>	<i>86</i>	<i>96</i>

WELL LOCATION:
 sec. *30* T. *2* S. R. *11* E. W. *Wiegla*
6 miles *N* of *Wiegla*
 (distance) (direction) (nearest town)

WELL PURPOSE: *HOME*
 (home, irrigation, municipal, industrial)

WELL COMPLETION DATA:

(1) diameter (inches) *2"*

(2) total depth (feet) *96'*

(3) static water level (feet) *40'* below top of ground.

(4) casing *PVC*, *91'*
 (material) (depth)

(size) if telescope see back.

(5) screen *5'*, *91'*
 (length) (depth to top)

2", *PVC*
 (size) (material)

(6) pump *1*, *8*
 (HP) (yield gpm)

Elect
 (type power)

(7) electric log *no*
 (yes or no)

(organization running log)

(8) how well bottom plugged *BWV*

RECEIVED


OCT 15 1987

Department of Natural Resources
 Bureau of Land & Water Resources

DRILLERS REMARKS:

If well telescopes please sketch and show depths.

GROUND LEVEL

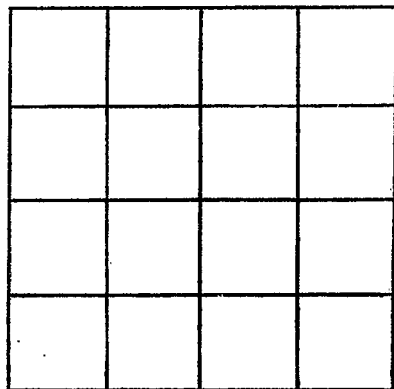

SECTION _____

Please indicate well location X.

ADDITIONAL INFORMATION

If more than one screen, show locations of each on sketch.