

MISSISSIPPI DEPARTMENT OF ENVIRONMENTAL QUALITY

Office of Land and Water Resources

P. O. Box 10631
Jackson, MS 39289-0631
WATER WELL DRILLERS LOG

COUNTY WELL LOCATED Perry Co.	
WELL NUMBER 2026	CODED
DATE WELL COMPLETED 7-18-95	

PERMIT NUMBER
NAME OF DRILLING FIRM Boone's Water Well

NAME & MAILING ADDRESS OF LANDOWNER Randy Copfield My Wy 29 Wiggins		
WELL LOCATION: SEC	TOWNSHIP	RANGE
33	1	N 11 E
DISTANCE	DIRECTION	NEAREST TOWN
_____ Miles	_____ of _____	
OTHER LANDMARK		
WELL PURPOSE: <input checked="" type="checkbox"/> Home Irrigation, Municipal, Industrial, Fish Pond, etc.		

PUMP DATA		
PUMP TYPE (Circle One): <input checked="" type="checkbox"/> Submersible, Turbine, Jet, Flowing Well, Other (Describe) _____		
POWER TYPE (Circle One): <input checked="" type="checkbox"/> Electric, Tractor, Diesel, Gasoline, Butane, Other (Describe) _____ H/P 172		
Pump Capacity (GPM)	No. of Stages	Setting Depth _____ FT.
PUMP TEST		
Well yielded _____ GPM with a drawdown of _____ ft. after _____ hours of pumping		

WELL DATA		
Well Depth 80	Casing Diameter (In.) 4	Casing Length (Ft.) 60
Type of Casing 5ch 40	Hole Depth	Depth to Static Water Level 28ft.

LOG DATA	
TYPE OF LOG RUN (Circle One): No Log Run, Electric, Gamma Ray, Density, Sonic, Neutron, Other (Describe) _____	
Name of Organization Running Log	

TYPE OF COMPLETION: (Circle One or More): <input checked="" type="checkbox"/> Gravel Packed, Underreamed, Telescoped, Natural Development, Open Hole, Other (Describe) _____		
---	--	--

GEOLOGIC DATA (Office Use Only)			
Surface Elev.	Geologic Unit	Unit Thickness	Depth to Top
Subs. SWL	Date	Analysis	Aquifer Test

WELL GROUTED TO A DEPTH OF 6 FEET Type Grout (circle one): <input checked="" type="checkbox"/> Cement, Bentonite, or Mix
--

Driller's Remarks	
Top of Lap Pipe or Reduction in Casing _____ FEET <small>IF TELESCOPED OR MORE THAN ONE SCREEN: USE BACK PAGE</small>	

SCREEN DATA		
Diameter - Inches 4	Length - Feet 20	Slot Size - Inches 8
Screen Type 5ch 40	Depth to Bottom - Feet	

DESCRIPTION OF FORMATIONS ENCOUNTERED	FROM	TO	FORMATIONS (Continued)	
			FROM	TO
Clay	0	10		
sand	10	80		

RECEIVED


JAN 29 1995

Dept. of Environmental Quality
Office of Land & Water Resources

IF MORE SPACE IS NEEDED, USE BACK

If well telescopes please
sketch and show depths.

GROUND LEVEL

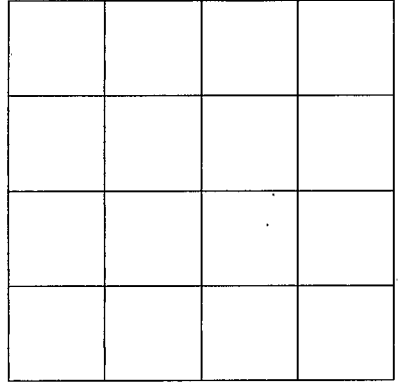

SECTION _____

Please indicate well location X.

ADDITIONAL INFORMATION

If more than one screen,
show location of each on sketch.