

Perry  
R4  
2-68

MISSISSIPPI  
BOARD OF WATER COMMISSIONERS  
416 North State Street  
Jackson, Mississippi 39201

CODED

WATER WELL DRILLERS LOG

2-5 1968 L.W. Smith Perry  
date well completed firm name county well located

LANDOWNER: Melvin Ireland  
Wiggins Miss.  
P.O.  
(mailing address)

description of formations encountered	from	to
Top Soil	0	2
Loam	2	68
Sand	68	96
Clay	96	

WELL LOCATION:  
sec. 29 T. 1 N. R. 10 E.  
S W  
10 miles East of Wiggins  
(distance) (direction) (nearest town)

WELL PURPOSE:  
(home, irrigation, municipal, industrial)


- WELL COMPLETION DATA:
- (1) diameter (inches) \_\_\_\_\_
  - (2) total depth (feet) 96
  - (3) static water level (feet) 68' below top of ground.
  - (4) casing Galvanized 93'  
(material) (depth)
  - \_\_\_\_\_ If telescope see back.  
(size)
  - (5) screen 3' 93'  
(length) (depth to top)
  - 2" \_\_\_\_\_  
(size) (material)
  - (6) pump 1 8  
(HP) (yield gpm)
  - Electric  
(type power)
  - (7) electric log \_\_\_\_\_  
(yes or no)
  - \_\_\_\_\_ (organization running log)
  - (8) how well bottom plugged Backfilled

DRILLERS REMARKS:

JUN - 7 1968  
MISS. BOARD OF  
WATER COMMISSIONERS

If well telescopes please sketch and show depths.

GROUND LEVEL

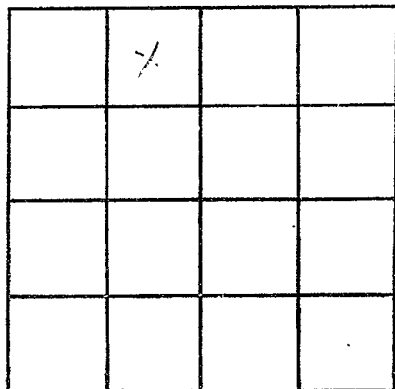

SECTION \_\_\_\_\_

Please indicate well location X.

ADDITIONAL INFORMATION

If more than one screen, show locations of each on sketch.