

Perry  
R 5  
2-3-68

MISSISSIPPI  
BOARD OF WATER COMMISSIONERS  
416 North State Street  
Jackson, Mississippi 39201

WATER WELL DRILLERS LOG

2-3 1968 Lewis Smith Perry  
date well completed firm name county well located

LANDOWNER: J W McAuliffe  
Hattiesburg  
(mailing address)

description of formations encountered	from	to
Top Soil	0	2
Clay	2	40
Sand	40	60
Clay		

WELL LOCATION:  
sec. 3 T. 1 R. 10 W  
14 miles NE of Wiggins  
(distance) (direction) (nearest town)

WELL PURPOSE:  
(home, irrigation, municipal, industrial)

- WELL COMPLETION DATA:
- (1) diameter (inches) 2
  - (2) total depth (feet) 60
  - (3) static water level (feet) 50 below top of ground.
  - (4) casing Plastic, 60'  
(material) (depth)  
if telescope see back.  
(size)
  - (5) screen 5', 55'  
(length) (depth to top)  
2", Plastic  
(size) (material)
  - (6) pump 1/2, 6 gal  
(HP) (yield gpm)  
Electric  
(type power)
  - (7) electric log \_\_\_\_\_  
(yes or no)  
(organization running log)
  - (8) how well bottom plugged Back W

DRILLERS REMARKS:

EXCEL


EXCEL

FEB - 4 1969

MISS. BD. OF WATER COMMISSIONERS

If well telescopes please sketch and show depths.

GROUND LEVEL

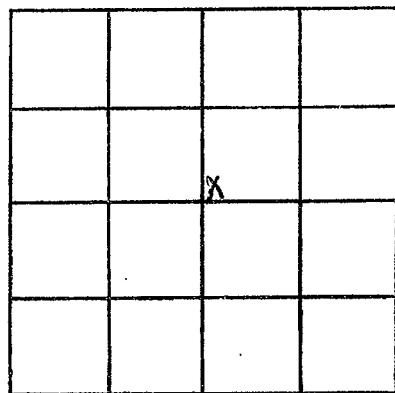

SECTION 3

Please indicate well location X.

ADDITIONAL INFORMATION

If more than one screen, show locations of each on sketch.