

Perry  
R 6  
6-24-69

MISSISSIPPI  
BOARD OF WATER COMMISSIONERS  
416 North State Street  
Jackson, Mississippi 39201

CODED

WATER WELL DRILLERS LOG

6-24 1969 date well completed  
B W Smith firm name  
Perry county well located

LANDOWNER:  
Lester Hayes  
Wiggins  
(mailing address)

description of formations encountered	from	to
Sandy clay	0	50
Sand	50	125
Sand + Gravel	125	145

WELL LOCATION:  
sec 30 T 1 S R 10 W  
8 miles NE of Wiggins  
(distance) (direction) (nearest town)

WELL PURPOSE:  
(home, irrigation, municipal, industrial)


- WELL COMPLETION DATA:
- (1) diameter (inches) 2"
  - (2) total depth (feet) 145'
  - (3) static water level (feet) 99' below above top of ground.
  - (4) casing Plastic 140 (material) (depth)
  - (size) if telescope see back.
  - (5) screen 5' 140' (length) (depth to top)
  - (size) (material)
  - (6) pump 1 9 (HP) (yield gpm)
  - (type power)
  - (7) electric log (yes or no)
  - (organization running log)
  - (8) how well bottom plugged B.W.

DRILLERS REMARKS:

JUL 30 1969		
MISS. BD. OF WATER COMM.		

If well telescopes please sketch and show depths.

GROUND LEVEL

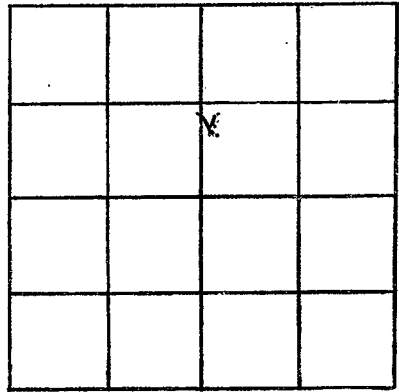

SECTION \_\_\_\_\_

Please indicate well location X.

ADDITIONAL INFORMATION

If more than one screen,  
show locations of each on sketch.