

changed From $\phi 9$ to R8

MISSISSIPPI
BOARD OF WATER COMMISSIONERS
416 North State Street
Jackson, Mississippi 39201

PERRY
~~R8~~ R8
2-5-68

WATER WELL DRILLERS LOG

2-5 1968 L W Smith Perry
date well completed firm name county well located

LANDOWNER: Melvin Ireland

Wiggins Route

(mailing address)

WELL LOCATION:

sec. 29 T 1 S R 10 W

(distance) miles (direction) of (nearest town)

WELL PURPOSE:

(home, irrigation, municipal, industrial)

WELL COMPLETION DATA:

- (1) diameter (inches) 2
- (2) total depth (feet) 96
- (3) static water level (feet) 68 below above top of ground.
- (4) casing Gal. (material), (depth),
If telescope see back.
(size)
- (5) screen 5' 91" (length), (depth to top)
2" Gal. (size), (material)
- (6) pump 1 8 (HP), (yield gpm)
Electric (type power)
- (7) electric log (yes or no)
(organization running log)
- (8) how well bottom plugged Back W

description of formations encountered

from to

description of formations encountered	from	to
Top Soil	0	1
Sandy Clay	1	52
Sand	52	90
Sand & Gravel Clay	90	96


FEB 4 1968

MISS. Bd. of WATER COMMISSIONERS

DRILLERS REMARKS:

If well telescopes please sketch and show depths.

GROUND LEVEL

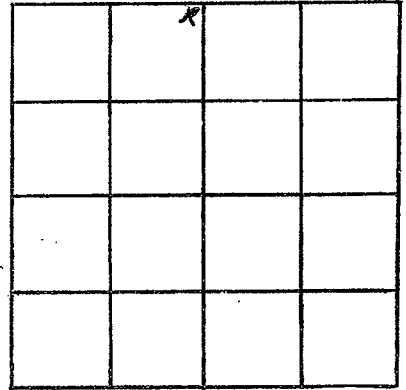

SECTION _____

Please indicate well location X.

ADDITIONAL INFORMATION

If more than one screen,
show locations of each on sketch.