

PERRY  
R 9  
5-4-71

MISSISSIPPI  
BOARD OF WATER COMMISSIONERS  
416 North State Street  
Jackson, Mississippi 39201

**CODED**

WATER WELL DRILLERS LOG

5-4-1971 Parnell Anderson Perry  
date well completed firm name county well located

LANDOWNER: J. C. Davis, Jr.  
  
(mailing address)

description of formations encountered	from	to
Top Soil	0	3
Red Clay	3	19
Fine Sand	19	26
Coarse Sand	26	34

WELL LOCATION:  
sec. 26 T. 1 S. R. 10 E. W.  
  
(distance) miles (direction) of (nearest town)

WELL PURPOSE: Home  
(home, irrigation, municipal, industrial)

WELL COMPLETION DATA:  
 (1) diameter (inches) 2"  
 (2) total depth (feet) 34'  
 (3) static water level (feet) 18 below above top of ground.  
 (4) casing Plastic, 28' (material) (depth)  
2" (size) if telescope see back.  
 (5) screen 6, 28' (length) (depth to top)  
2", Plastic (size) (material)  
 (6) pump 1, 8 (HP) (yield gpm)  
Elect (type power)  
 (7) electric log no (yes or no)  
 (organization running log)

**CODED**

(8) how well bottom plugged  
Backwash Valve


JUN 3 1971

DRILLERS REMARKS:

MISS. RD. 0  
WATER

If well telescopes please sketch and show depths.

GROUND LEVEL

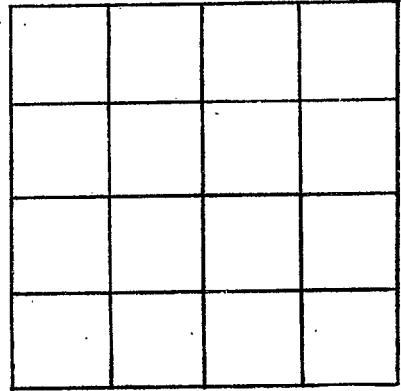

SECTION \_\_\_\_\_

Please indicate well location X.

ADDITIONAL INFORMATION

If more than one screen, show locations of each on sketch.