

MISSISSIPPI
BOARD OF WATER COMMISSIONERS
416 North State Street
Jackson, Mississippi 39201

CODED

WATER WELL DRILLERS LOG

PERRY
R 10
4-17-70

4-17 19**70** **Parnell Anderson** **Perry**
date well completed firm name county well located

LANDOWNER: **Oliver Johnson**
Wiggins Miss
(mailing address)

description of formations encountered	from	to
Red Clay	0	31
Fine Sand	31	38
Red Clay	38	51
Fine Sand	51	66
Coarse Sand	66	77

WELL LOCATION:
sec. **12** T. **1** N. R. **10** W.
S. W.
21 miles **E** of **Wiggins**
(distance) (direction) (nearest town)

WELL PURPOSE: **Home**
(home, irrigation, municipal, industrial)

- WELL COMPLETION DATA:
- (1) diameter (inches) **2**
 - (2) total depth (feet) **77**
 - (3) static water level (feet) **50** below above top of ground.
 - (4) casing **Plastic**, **71**,
(material) (depth)
(size) if telescope see back.
 - (5) screen **6**, **71**
(length) (depth to top)
2", **Plastic**
(size) (material)
 - (6) pump **1**, **7**
(HP) (yield gpm)
Electric
(type power)
 - (7) electric log (yes or no)
 - (organization running log)
 - (8) how well bottom plugged
Backwash Valve

CODED


JUN 11 1971

DRILLERS REMARKS:

MISS. BD. OF
WATER COM.

If well telescopes please sketch and show depths.

GROUND LEVEL

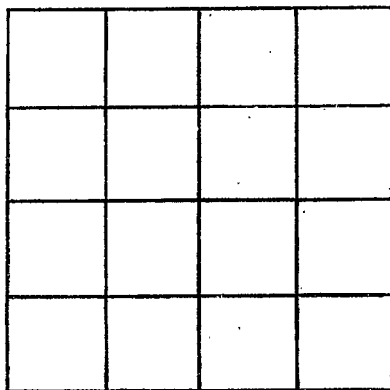

SECTION _____

Please indicate well location X.

ADDITIONAL INFORMATION

If more than one screen,
show locations of each on sketch.