

PERRY

MISSISSIPPI BOARD OF WATER COMMISSIONERS  
416 North State Street  
Jackson, Mississippi 39201

**CODED**

WATER WELL DRILLERS LOG

*Camp*  
*Highwell*  
*R 11*  
*T-18-73*


*7-18* 19*73* *Sumner Well Drilling Co Perry*  
date well completed firm name county well located

LANDOWNER	description of formations encountered	from	to
<i>Jerry Mayfield</i>			
<i>108 Wilson Dr.</i>	<i>Clay</i>	<i>0</i>	<i>10</i>
<i>Petal Miss.</i> (mailing address)	<i>Gravel</i>	<i>10</i>	<i>15</i>
WELL LOCATION:	<i>Clay</i>	<i>15</i>	<i>140</i>
sec. <i>5</i> T <i>1</i> N <i>R 10</i> E <i>W 3</i>	<i>Clay</i>	<i>140</i>	<i>143</i>
<i>11</i> miles <i>SW</i> <i>New Aqueduct</i>	<i>Gravel</i>	<i>143</i>	<i>149</i>
(distance) (direction) (nearest town)	<i>Clay</i>	<i>149</i>	<i>202</i>
WELL PURPOSE: <i>Camp</i> (home, irrigation, municipal, industrial)	<i>Gravel</i>	<i>202</i>	<i>219</i>
WELL COMPLETION DATA:	<i>Gravel</i>	<i>219</i>	<i>230</i>
(1) diameter (inches) <i>2"</i>	<i>Gravel</i>	<i>230</i>	<i>255</i>
(2) total depth (feet) <i>350 ft</i>	<i>Gravel</i>	<i>255</i>	<i>332</i>
(3) static water level (feet) <i>27 ft</i> <sup>below</sup> / <sub>above</sub> top of ground	<i>Gravel</i>	<i>332</i>	<i>350</i>
(4) casing <i>Plastic</i> , <i>240 ft</i> (material) (depth)			
<i>2"</i> if telescope see back. (size)			
(5) screen <i>10 ft</i> , <i>350 ft</i> (length) (depth to top)			
<i>2"</i> , <i>Plastic</i> (size) (material)			
(6) pump <i>1</i> , <i>900 gpm</i> (HP) (yield gpm)			
<i>2.0</i> (type power)			
(7) electric log <i>C</i> (yes or no)			
(organization running log)			
(8) how well bottom plugged <i>Valve</i>			
DRILLERS REMARKS:			

**LOG 1 1973**

If well telescopes please sketch and show depths.

GROUND LEVEL

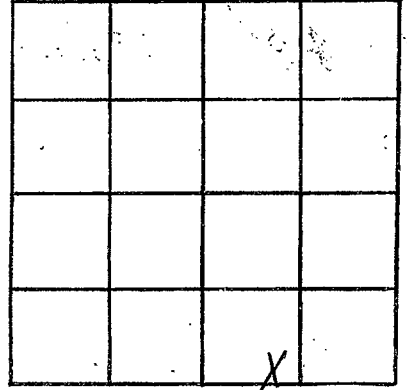

SECTION \_\_\_\_\_

Please indicate well location X.

ADDITIONAL INFORMATION

If more than one screen,  
show locations of each on sketch.