

Perry

MISSISSIPPI BOARD OF WATER COMMISSIONERS
416 North State Street
Jackson, Mississippi 39201

CODED

WATER WELL DRILLERS LOG

7-16-73
7-16-73
date well completed

1973 James H. Drilling & Perry
firm name

county well located

LANDOWNER: J. D. Lewis

description of formations encountered

from

to

Road R
Hattiesburg miss
(mailing address)

Clay 0 8
Sand & Gravel 8 19

WELL LOCATION:

sec 5 T 1 N R 10 E
14 miles SW of W (nearest town)
(distance) (direction)

Clay 19 92
Shell 92 142

WELL PURPOSE: Lake
(home, irrigation, municipal, industrial)

Clay 142 173
Fire Sand 173 181

WELL COMPLETION DATA:

- (1) diameter (inches) 4"
- (2) total depth (feet) 310 ft
- (3) static water level (feet) 7 ft below top of ground.
- (4) casing Plastic, 300 ft (depth)

Shell 181 220
Fire Sand 220 276
Old gravel 276 310

4" if telescope see back.
(size)

- (5) screen 10 ft, 310 ft (length) (depth to top)

4", Plastic (size) (material)

- (6) pump 1 (HP), 1500 gpm (yield gpm)

Sub (type power)

- (7) electric log ✓ (yes or no)

(organization running log)

- (8) how well bottom plugged None


AUG 1 1973

DRILLERS REMARKS:

MISS. DIV. OF WATER CONTROL

If well telescopes please sketch and show depths.

GROUND LEVEL

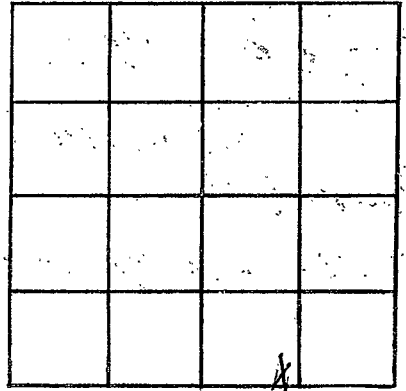

SECTION _____

Please indicate well location X.

ADDITIONAL INFORMATION

If more than one screen,
show locations of each on sketch.