

Perry  
 R 16  
 11-6-79

MISSISSIPPI  
 BOARD OF WATER COMMISSIONERS CODED  
 416 North State Street  
 Jackson, Mississippi 39201

WATER WELL DRILLERS LOG

11-6 19 Pernell Anderson Perry  
 date well completed firm name county well located

LANDOWNER:  
Tommy Johnson  
 (mailing address)

WELL LOCATION:  
 sec. 1 T 1 R 10  
18 miles NE of Perry  
 (distance) (direction) (nearest town)

WELL PURPOSE: HOME  
 (home, irrigation, municipal, industrial)

WELL COMPLETION DATA:  
 (1) diameter (inches) 8"  
 (2) total depth (feet) 82'  
 (3) static water level (feet) 56' below ~~above~~ top of ground.  
 (4) casing Plastic 77'  
 (material) (depth)  
 (size) if telescope see back.  
 (5) screen 5' 77'  
 (length) (depth to top)  
2" Plastic  
 (size) (material)  
 (6) pump 1 10  
 (HP) (yield gpm)  
Elect  
 (type power)  
 (7) electric log no  
 (yes or no)  
 (organization running log)

description of formations encountered	from	to
Top Soil	0	4
Sandy clay	0	18
Fine Sand	18	70
Coarse Sand	70	82


CODED

RECEIVED  
 DEC 6 1974

(8) how well bottom plugged  
Plugged  
 DRILLERS REMARKS:

If well telescopes please sketch and show depths.

GROUND LEVEL

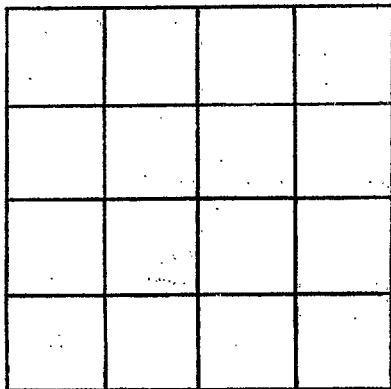

SECTION \_\_\_\_\_

Please indicate well location X.

ADDITIONAL INFORMATION

If more than one screen, show locations of each on sketch.