

R 17
 Perry
 5/19/75

MISSISSIPPI
 BOARD OF WATER COMMISSIONERS
 416 North State Street
 Jackson, Mississippi 39201

CODED

WATER WELL DRILLERS LOG

5-19 19 Parnell Anderson Perry
 date well completed firm name county well located

LANDOWNER:
Willie Scarborough
 (mailing address)

description of formations encountered	from	to
<u>Top Soil</u>	<u>0</u>	<u>4</u>
<u>Red clay</u>	<u>4</u>	<u>30</u>
<u>Coarse Sand</u>	<u>30</u>	<u>103</u>

WELL LOCATION:
 sec. 4 T. 1 N. R. 10 E.
~~3~~ 3 miles SE of Junico
 (distance) (direction) (nearest town)

WELL PURPOSE: HOME
 (home, irrigation, municipal, industrial)

- WELL COMPLETION DATA:
- (1) diameter (inches) 2"
 - (2) total depth (feet) 103'
 - (3) static water level (feet) 5.3 below above top of ground.
 - (4) casing Plastic 98'
 (material) (depth)
 (size) If telescope see back.
 - (5) screen 5' 98'
 (length) (depth to top)
5' Plastic
 (size) (material)
 - (6) pump 1 9
 (HP) (yield gpm)
Elect
 (type power)
 - (7) electric log NO
 (yes or no)

(organization running log)
 (8) how well bottom plugged
Backward Valve

DRILLERS REMARKS:


RECEIVED

JUN 5 1975

MISS. BD. OF WATER COMM

If well telescopes please sketch and show depths.

GROUND LEVEL

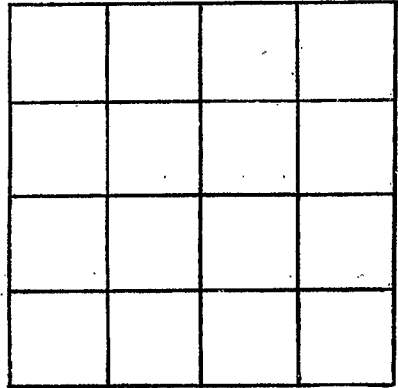

SECTION _____

Please indicate well location X.

ADDITIONAL INFORMATION

If more than one screen, show locations of each on sketch.