

CODED

R 18
Perry
5/16/25

MISSISSIPPI
BOARD OF WATER COMMISSIONERS
416 North State Street
Jackson, Mississippi 39201

WATER WELL DRILLERS LOG

5-16 1925 date well completed
25 Powell Anderson Perry firm name county well located

LANDOWNER:
H. W. Dickens
(mailing address)

description of formations encountered	from	to
Top Soil	0	4'
Sandy clay	4	22'
Coarse Sand	22	51'

WELL LOCATION:
sec. 4 T. 1 N. R. 10 W.
3 miles SE of Janice
(distance) (direction) (nearest town)

WELL PURPOSE: HOME
(home, irrigation, municipal, industrial)

- WELL COMPLETION DATA:
- (1) diameter (inches) 5"
 - (2) total depth (feet) 51'
 - (3) static water level (feet) 30 below top of ground.
 - (4) casing Plastic 46 (material) (depth)
 - (size) if telescope see back.
 - (5) screen 5' 46' (length) (depth to top)
 - 5" Plastic (size) (material)
 - (6) pump 1 10 (HP) (yield gpm)
 - Elect (type power)
 - (7) electric log no. (yes or no)

(organization running log)


(8) how well bottom plugged
Plugged

DRILLERS REMARKS:

RECEIVED
MAY 19 5 1925

If well telescopes please sketch and show depths.

GROUND LEVEL

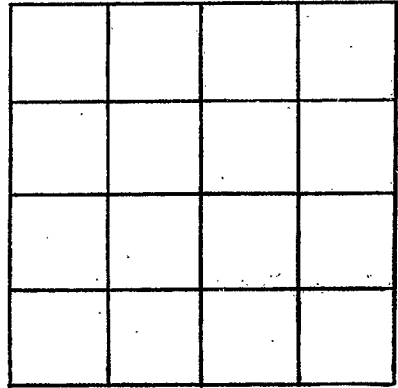

SECTION _____

Please indicate well location X.

ADDITIONAL INFORMATION

If more than one screen, show locations of each on sketch.