

R 19
 Perry R.
 5/14/75

MISSISSIPPI
 BOARD OF WATER COMMISSIONERS
 416 North State Street
 Jackson, Mississippi 39201

CODED

WATER WELL DRILLERS LOG

5-14 1975 Garrett Anderson Perry
 date well completed firm name county well located

LANDOWNER:	description of formations encountered	from	to
<u>Moss Kill Church</u>			
(mailing address)	<u>Red Clay</u>	<u>4</u>	<u>35</u>
WELL LOCATION:	<u>White Clay</u>	<u>35</u>	<u>60</u>
sec <u>29</u> T <u>1</u> S R <u>10</u> E	<u>Coast Sand</u>	<u>60</u>	<u>85</u>
<u>16</u> miles <u>NE</u> of <u>Arley</u>			
(distance) (direction) (nearest town)			
WELL PURPOSE: <u>Church</u>			
(home, irrigation, municipal, industrial)			
WELL COMPLETION DATA:			
(1) diameter (inches) <u>2"</u>			
(2) total depth (feet) <u>85'</u>			
(3) static water level (feet) <u>60'</u> below top of ground.			
(4) casing <u>Plastic</u> , <u>80'</u>			
(material) (depth)			
(size) if telescope see back.			
(5) screen <u>5'</u> , <u>80'</u>			
(length) (depth to top)			
<u>2"</u> , <u>Plastic</u>			
(size) (material)			
(6) pump <u>1</u> <u>7</u>			
(HP) (yield gpm)			
<u>Elect</u>			
(type power)			
(7) electric log <u>no</u>			
(yes or no)			
(organization running log)			
(8) <u>well bottom plugged</u>			
<u>Backwash valve</u>			
DRILLERS REMARKS:			


RECEIVED
 RECEIVED

JUN 5 1975

MISS. BD. OF WATER COMM

If well telescopes please
sketch and show depths.

GROUND LEVEL

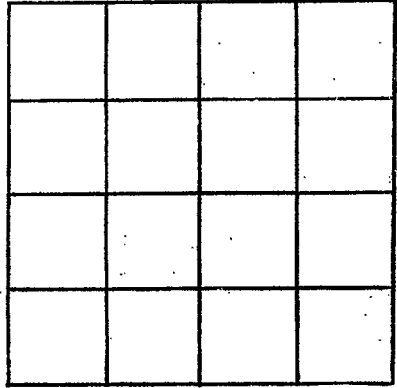

SECTION _____

Please indicate well location X.

ADDITIONAL INFORMATION

If more than one screen,
show locations of each on sketch.