

Perry
R 20
10/9/80

MISSISSIPPI
BOARD OF WATER COMMISSIONERS
416 North State Street
Jackson, Mississippi 39201

CODED

WATER WELL DRILLERS LOG

Spinner Drilling Service, Inc.

Perry

10-9-80
date well completed

firm name

county well located

LANDOWNER:
Florida Gas Exploration
1444 Capital Towers
Jackson, Ms 39201
(mailing address)

description of formations encountered	from	to
<i>Clay, sand & gravel, clay</i>	<i>0</i>	<i>35</i>
<i>clay and sand</i>	<i>35</i>	<i>224</i>
<i>sand</i>	<i>224</i>	<i>287</i>
<i>clay and sand</i>	<i>287</i>	<i>392</i>
<i>sand and gravel</i>	<i>392</i>	<i>455</i>

WELL LOCATION: *2400' N & 2150' E*
No 1 Josephine Unit
sec *35* T *1* N R *10* E of *Black Creek*
Unit *35-11* miles *3.5* direct *Black Creek* (nearest town)
(distance)

WELL PURPOSE: *oil field supply*
(home, irrigation, municipal, industrial)

WELL COMPLETION DATA:

- (1) diameter (inches) *3"*
- (2) total depth (feet) *455'*
- (3) static water level (feet) *flooding* above top of ground.
- (4) casing *steel, 453'*
(material) (depth)
3" (size) if telescope see back.
- (5) screen *42', 413'*
(length) (depth to top)
3" perforated (size) (material)
- (6) pump *75*
(HP) (yield gpm)
ac (type power)
- (7) electric log *—*
(yes or no)

(organization running log)

(8) how well bottom plugged *orange peel*

DRILLERS REMARKS:


DEPT. OF NATURAL RESOURCES
BUREAU OF LAND & WATER RESOURCES

OCT 23 1980

RECEIVED

If well telescopes please sketch and show depths.

GROUND LEVEL

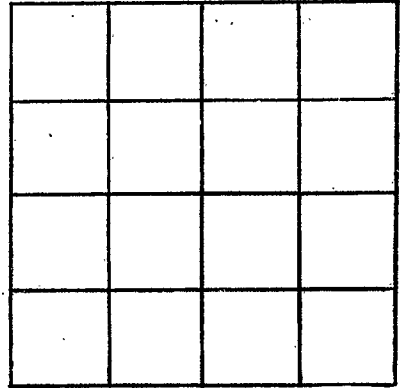

SECTION _____

Please indicate well location X.

ADDITIONAL INFORMATION

If more than one screen,
show locations of each on sketch.