

MISSISSIPPI DEPARTMENT OF NATURAL RESOURCES

Bureau of Land and Water Resources

Southport Mall

P.O. Box 10631

Jackson, Mississippi 39209

WATER WELL DRILLERS LOG

CODED

R21
 PERRY
 11-26-84

11-26 1984 date well completed
 Frank Perry firm name
 Perry county well located

LANDOWNER:
 Colman Davis
 (mailing address)

WELL LOCATION:
 sec. 26 T. 1 S. R. 10 E.
 3 miles W of DEEP CREEK
 (distance) (direction) (nearest town)

WELL PURPOSE: HOME
 (home, irrigation, municipal, industrial)

WELL COMPLETION DATA:

(1) diameter (inches) 2"

(2) total depth (feet) 420'

(3) static water level (feet) 50' below top of ground.

(4) casing PVC, 420' (material) (depth)
 (size) If telescope see back.

(5) screen 10', 420' (length) (depth to top)
 2, PVC (size) (material)

(6) pump 1, 9 (HP) (yield gpm)
 Elect (type power)

(7) electric log NO (yes or no)
 (organization running log)

(8) how well bottom plugged B W V

description of formations encountered	from	to
Top Soil	0	3
Sands	3	28
Blue Clay	28	34.5
Flint Sand	34.5	41.5
Course Sand	41.5	43.0

DEPT. OF NATURAL RESOURCES
 BUREAU OF LAND & WATER RESOURCES


DEC -7 1984

RECEIVED

DRILLERS REMARKS:

If well telescopes please sketch and show depths.

GROUND LEVEL

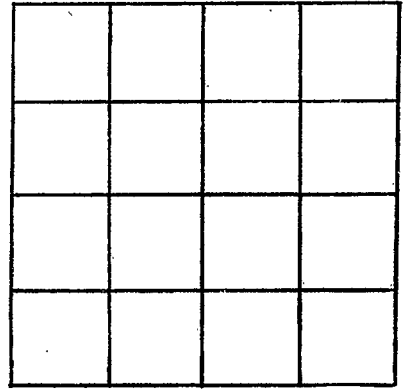

SECTION _____

Please indicate well location X.

ADDITIONAL INFORMATION

If more than one screen,
show locations of each on sketch.