

PERRY

R 2002

MISSISSIPPI
BOARD OF WATER COMMISSIONERS
416 North State Street
Jackson, Mississippi 39201

WATER WELL DRILLERS LOG

7-26-1978 Perrell Professional Perry
date well completed firm name county well located


LANDOWNER:	description of formations encountered	from	to
<u>Malcom Fairley</u>	<u>Top Soil</u>	<u>0</u>	<u>3</u>
(mailing address)	<u>Sand</u>	<u>3</u>	<u>33</u>
WELL LOCATION: sec <u>25</u> T <u>1</u> # <u>R</u> <u>10</u> S <u>W</u> <u>9</u> miles <u>SE</u> of <u>Nautil</u> (distance) (direction) (nearest town)	<u>Blue Clay</u>	<u>35</u>	<u>112</u>
WELL PURPOSE: <u>HOME</u> (home, irrigation, municipal, industrial)	<u>Flint Sand</u>	<u>112</u>	<u>121</u>
WELL COMPLETION DATA: (1) diameter (inches) <u>2</u> (2) total depth (feet) <u>328</u> (3) static water level (feet) <u>128</u> below top of ground (4) casing <u>Plastic</u> , <u>320'</u> (material) (depth) (size) If telescope see back. (5) screens <u>5'</u> , <u>320'</u> (length) (depth to top) <u>2"</u> , <u>Plastic</u> (size) (material) (6) pump <u>1</u> , <u>4</u> (HP) (yield gpm) <u>Elect</u> (type power) (7) electric log <u>no</u> (yes or no) (organization running log) (8) how well bottom plugged <u>Back wash valve</u>	<u>Blue Clay</u>	<u>121</u>	<u>312</u>
DRILLERS REMARKS:	<u>Coarse Sand</u>	<u>312</u>	<u>325</u>

RECEIVED
AUG - 4 1978

MISS. BD. OF WATER COMM

If well telescopes please sketch and show depths.

GROUND LEVEL

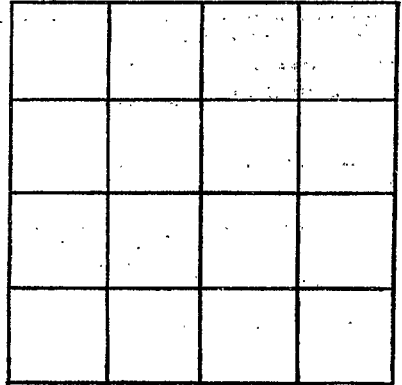

SECTION _____

Please indicate well location X.

ADDITIONAL INFORMATION

If more than one screen,
show locations of each on sketch.