

PERRY
 R 2003
 11-2778

MISSISSIPPI
 BOARD OF WATER COMMISSIONERS
 416 North State Street
 Jackson, Mississippi 39201

WATER WELL DRILLERS LOG

11-2 1978 Pamell Anderson Perry
 date well completed firm name county well located


LANDOWNER:	description of formations encountered	from	to
<u>Colan Hickman</u>	<u>Top Soil</u>	<u>0</u>	<u>2</u>
(mailing address)	<u>Sandy clay</u>	<u>2</u>	<u>18</u>
WELL LOCATION:	<u>clay</u>	<u>18</u>	<u>67</u>
sec <u>36 T 1 N</u> R <u>10 E</u> S W	<u>medium sand</u>	<u>67</u>	<u>84</u>
<u>2 1/2</u> miles <u>W</u> of <u>Dan Creek School</u> (distance) (direction) (nearest town)			
WELL PURPOSE: <u>HOME</u> (home, irrigation, municipal, industrial)			
WELL COMPLETION DATA:			
(1) diameter (inches) <u>2"</u>			
(2) total depth (feet) <u>84'</u>			
(3) static water level (feet) <u>32</u> below top of ground.			
(4) casing <u>Plastic 79'</u> (material) (depth)			
(size) if telescope see back.			
(5) screen <u>3" 79'</u> (length) (depth to top)			
<u>2" Plastic</u> (size) (material)			
(6) pump <u>1</u> <u>10</u> (HP) (yield gpm)			
<u>Elect</u> (type power)			
(7) electric log <u>no</u> (yes or no)			
(organization running log)			
(8) how well bottom plugged <u>Capped</u>			
DRILLERS REMARKS:			

RECEIVED
 DEC - 7 1978

MISS. BD. OF WATER COMMISSIONERS

If well telescopes please sketch and show depths.

GROUND LEVEL

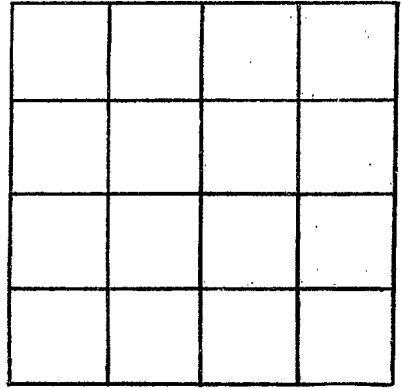

SECTION _____

Please indicate well location X.

ADDITIONAL INFORMATION

If more than one screen,
show locations of each on sketch.