

**MISSISSIPPI DEPARTMENT OF NATURAL RESOURCES**  
**Bureau of Land and Water Resources**  
 Southport Mall  
 P.O. Box 10631  
 Jackson, Mississippi 39209

**WATER WELL DRILLERS LOG**

Perry  
R 2004  
4-10-81  
April 10 19  
 date well completed

Parnell Anderson Stone  
 firm name

Perry  
 county well located

LANDOWNER: Butch Walters  
Rt 3  
Weygina, Ms 39577  
 (mailing address)

WELL LOCATION:  
 sec. 36 T. 1 N R. 10 E  
18 miles E of Weygina  
 (distance) (direction) (nearest town)

WELL PURPOSE: Home  
 (home, irrigation, municipal, industrial)

WELL COMPLETION DATA:

(1) diameter (inches) 2"

(2) total depth (feet) 105'

(3) static water level (feet) 40' below above top of ground

(4) casing 2" Pvc, 100'  
 (material) (depth)

         If telescope see back.  
 (size)

(5) screen 5' 100'  
 (length) (depth to top)

2" Pvc  
 (size) (material)

(6) pump 1 12  
 (HP) (yield gpm)


Electric  
 (type power)

(7) electric log NO  
 (yes or no)

          
 (organization running log)

(8) how well bottom plugged Capped  
Yes


description of formations encountered	from	to
<u>Top Soil</u>	<u>0</u>	<u>3</u>
<u>Sand</u>	<u>3</u>	<u>18</u>
<u>Blue Clay</u>	<u>18</u>	<u>80</u>
<u>Fine sand</u>	<u>80</u>	<u>90</u>
<u>Coarse sand</u>	<u>90</u>	<u>105</u>

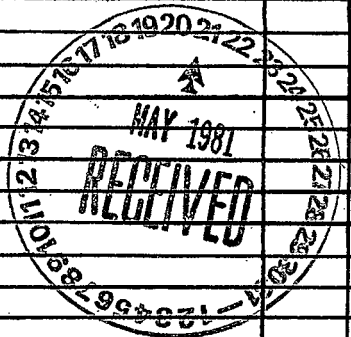

DRILLERS REMARKS:  
 \_\_\_\_\_  
 \_\_\_\_\_  
 \_\_\_\_\_

If well telescopes please sketch and show depths.

GROUND LEVEL

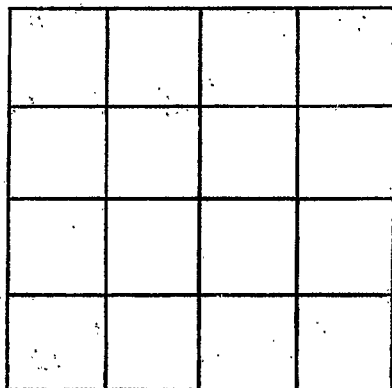

SECTION \_\_\_\_\_

Please indicate well location X.

ADDITIONAL INFORMATION

If more than one screen,  
show locations of each on sketch.