

MISSISSIPPI DEPARTMENT OF NATURAL RESOURCES

Bureau of Land and Water Resources

Southport Mall

P.O. Box 10631

Jackson, Mississippi 39209

WATER WELL DRILLERS LOG

*Perry*  
 R  
 2005

date well completed 2-23 1982 Frydogle Wm name Perry county well located

LANDOWNER: Charles Fairley

Pt. 1 Bnf 90 Leap ms.  
39450  
 (mailing address)

description of formations encountered

description of formations encountered	from	to
<u>Clay</u>	<u>0</u>	<u>10</u>
<u>Red Sand</u>	<u>10</u>	<u>20</u>
<u>Clay</u>	<u>20</u>	<u>30</u>
<u>Sand</u>	<u>30</u>	<u>44</u>
<u>Bran Clay</u>	<u>44</u>	<u>60</u>
<u>Blue Clay</u>	<u>60</u>	<u>120</u>
<u>Fine Sand</u>	<u>120</u>	<u>130</u>
<u>Hard Blue Clay</u>	<u>130</u>	<u>230</u>
<u>Ext Fine Sand + clay Strips</u>	<u>230</u>	<u>320</u>
<u>Med Course Sand</u>	<u>320</u>	<u>360</u>

WELL LOCATION:

2 1/2 miles S of MLB  
 (distance) (direction) (nearest town)

WELL PURPOSE:

(home, irrigation, municipal, industrial)

WELL COMPLETION DATA:

- (1) diameter (inches) 2
- (2) total depth (feet) 360
- (3) static water level (feet) 150 below top of ground.
- (4) casing PVC 350'  
 (material) (depth)  
1 1/2" if telescope see back.  
 (size)
- (5) screen 10' 350'  
 (length) (depth to top)  
2" PVC  
 (size) (material)
- (6) pump 1 1/2 5 1/2  
 (HP) (yield gpm)  
Elect Jet.  
 (type power)
- (7) electric log no  
 (yes or no)

(organization running log) no

- (8) how well bottom plugged PVC  
Ball Check

DRILLERS REMARKS:

good prep  
Well water, stable deep.  
We suggest


DEPT. OF NATURAL RESOURCES  
 BUREAU OF LAND & WATER RESOURCES

APR 6 1982

RECEIVED

If well telescopes please  
sketch and show depths.

GROUND LEVEL

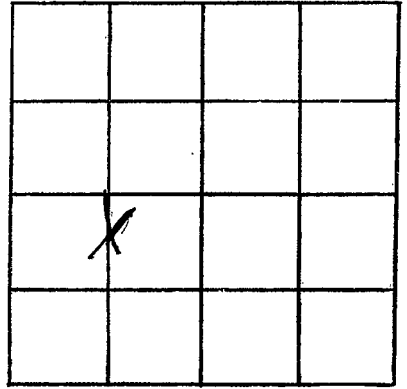

SECTION 102

Please indicate well location X.

ADDITIONAL INFORMATION

If more than one screen,  
show locations of each on sketch.