

MISSISSIPPI DEPARTMENT OF NATURAL RESOURCES

Bureau of Land and Water Resources

Southport Mall

P.O. Box 10631

Jackson, Mississippi 39209

WATER WELL DRILLERS LOG

Perry
R 2000

Dec 11 1984 Farnell Anderson Perry
date well completed firm name county well located

LANDOWNER: Tony Bond
Wiggins, MS
(mailing address)

description of formations encountered	from	to
TOP soil	0	3
Sand	3	16
Clay	16	34
Sand	34	52
Clay	52	81
Sand	81	98

WELL LOCATION:
sec 25 T 1 S R 10 E W
20 miles NE of Wiggins
(distance) (direction) (nearest town)

WELL PURPOSE: Home
(home, irrigation, municipal, industrial)

- WELL COMPLETION DATA:
- (1) diameter (inches) 2"
 - (2) total depth (feet) 98'
 - (3) static water level (feet) 90' below top of ground.
 - (4) casing PVC, 93'
(material) (depth)
(size) if telescope see back.
 - (5) screen 5', 93'
(length) (depth to top)
2" PVC
(size) (material)
 - (6) pump 1 (HP) (yield gpm)
Electric
(type power)
 - (7) electric log NO
(yes or no)
(organization running log)
 - (8) how well bottom plugged Correct


RECEIVED
JUN 17 1985

Department of
Bureau of Land and Water Resources

DRILLERS REMARKS:

If well telescopes please sketch and show depths.

GROUND LEVEL

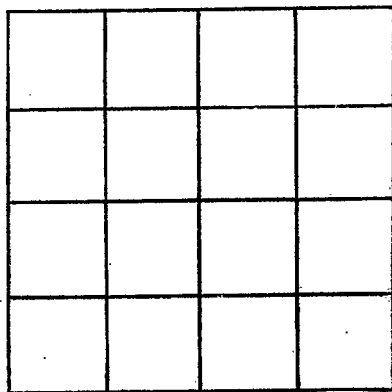

SECTION _____

Please indicate well location X.

ADDITIONAL INFORMATION

If more than one screen,
show locations of each on sketch.