

MISSISSIPPI DEPARTMENT OF NATURAL RESOURCES

Bureau of Land and Water Resources

Southport Mall

P.O. Box 10631

Jackson, Mississippi 39209

WATER WELL DRILLERS LOG

PERRY
R 2008

10-4 date well completed 19 85 firm name Perrywell Anderson Perry county well located

LANDOWNER: Gary Oglesbee
Rt. 1 Box 110B
Wiggins
(mailing address)

description of formations encountered	from	to
Top Spid	0	2
Sand	2	18
Clay	18	37
Sand	37	76

WELL LOCATION:
sec. 19 T 1 S R 10 W
16 miles E of Wiggins
(distance) (direction) (nearest town)

WELL PURPOSE: Home
(home, irrigation, municipal, industrial)

WELL COMPLETION DATA:

- (1) diameter (inches) 2
- (2) total depth (feet) 76
- (3) static water level (feet) 50 below top of ground.
- (4) casing PVC (71)
(material) (depth)
(size) If telescope see back.
- (5) screen 5' (71)
(length) (depth to top)
(size) (material)
- (6) pump 1 (9)
(HP) (yield gpm)
Fluo
(type power)
- (7) electric log _____
(yes or no)
(organization running log)
- (8) how well bottom plugged Cap


RECEIVED
JUN 17 1986

Department of Natural Resources
Bureau of Land & Water Resources

DRILLERS REMARKS:

If well telescopes please sketch and show depths.

GROUND LEVEL

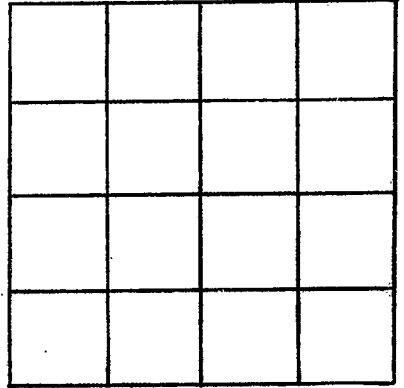

SECTION _____

Please indicate well location X.

ADDITIONAL INFORMATION

If more than one screen,
show locations of each on sketch.